


If well telescopes please sketch and show depths.


GROUND LEVEL

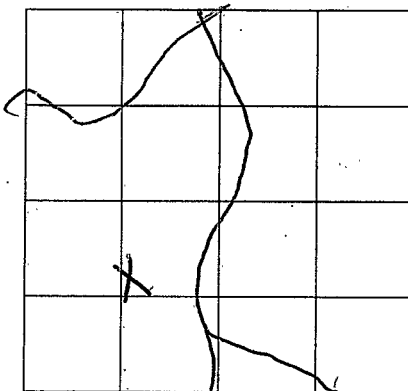

SECTION 25

Please indicate well location X.

ADDITIONAL INFORMATION

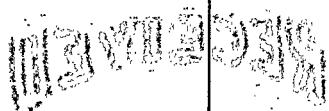

NOV 1 1990

NOV 1 1990

If more than one screen,
show location of each on sketch.