

MISSISSIPPI DEPARTMENT OF ENVIRONMENTAL QUALITY

Office of Land and Water Resources

P. O. Box 10631
Jackson, MS 39289-0631
WATER WELL DRILLERS LOG

COUNTY WELL LOCATED
Walthall

WELL NUMBER C 2033 CODED
2141

DATE WELL COMPLETED
10-22-99

PERMIT NUMBER
0-621

NAME OF DRILLING FIRM
Daniel Boone

Tylertown, Ms.

NAME & MAILING ADDRESS OF LANDOWNER
Tim Doskey

38 Jewell Thornhill

Tylertown, Ms.

WELL LOCATION: SEC 1 TOWNSHIP 3 S RANGE 10 W

DISTANCE 9 Miles DIRECTION North NEAREST TOWN Tylertown

OTHER LANDMARK

WELL PURPOSE: Home, Irrigation, Municipal, Industrial, Fish Pond, etc.

PUMP DATA

PUMP TYPE (Circle One):
 Submersible, Turbine, Jet, Flowing Well,
Other (Describe) _____

POWER TYPE (Circle One):
 Electric, Tractor, Diesel, Gasoline, Butane,
Other (Describe) _____ H/P 1

Pump Capacity (GPM) 12 No. of Stages _____ Setting Depth 90 FT.

PUMP TEST

Well yielded 25 GPM with
a drawdown of 30 ft.
after 10 hours of pumping

WELL DATA

Well Depth <u>1168'</u>	Casing Diameter (in.) <u>4"</u>	Casing Length (FT.) <u>148'</u>
Type of Casing <u>PVC</u>	Hole Depth <u>170'</u>	Depth to Static Water Level <u>45'</u>

TYPE OF COMPLETION: (Circle One or More):
 Gravel Packed, Underreamed, Telescoped,
 Natural Development, Open Hole, Other
(Describe) _____

WELL GROUTED TO A DEPTH OF 8 FEET
Type Grout (circle one): Cement, Bentonite, or Mix

LOG DATA

TYPE OF LOG RUN (Circle One):
 No Log Run, Electric, Gamma-Ray, Density, Sonic, Neutron,
Other (Describe) _____

Name of Organization Running Log _____

SCREEN DATA

Diameter - Inches <u>4"</u>	Length - Feet <u>20'</u>	Slot Size - Inches <u>.008</u>
Screen Type <u>PVC Sch. 40</u>	Depth to Bottom - Feet <u>2'</u>	

GEOLOGIC DATA (Office Use Only)

Surface Elev.	Geologic Unit	Unit Thickness	Depth to Top
Subs. SWL	Date	Analysis	Aquifer Test

Driller's Remarks _____

Top of Lap Pipe or Reduction in Casing _____


FEET IF TELESCOPED OR MORE THAN ONE SCREEN: USE BACK PAGE

DESCRIPTION OF FORMATIONS ENCOUNTERED	FROM	TO	FORMATIONS (Continued)	FROM	TO
Clay	0	8			
Sand	8	32			
Clay	32	55			
Sand	55	170			

IF MORE SPACE IS NEEDED: USE BACK

If well telescopes please
sketch and show depths.

GROUND LEVEL

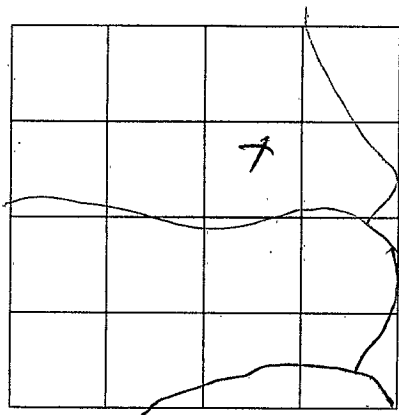

SECTION 1

Please indicate well location X.

ADDITIONAL INFORMATION

If more than one screen,
show location of each on sketch.