

WALTHALL

D3

6-28-71

MISSISSIPPI BOARD OF WATER COMMISSIONERS

416 North State Street  
Jackson, Mississippi 39201

**CODED**

WATER WELL DRILLERS LOG

6-28 1971  
date well completed

Fitzgerald Dr  
firm name

Walthall  
county well located

LANDOWNER:

Ollie Regatt

R.R. Tylertown  
(mailing address)

description of formations encountered

from to

|                      |    |    |
|----------------------|----|----|
| Red clay             | 0  | 70 |
| White clay           | 10 | 40 |
| Coarse sand & gravel | 40 | 66 |

WELL LOCATION:

sec 29 T 30 S R 11 E  
5 miles N of Tylertown  
(distance) (direction) (nearest town)

WELL PURPOSE:

(home, irrigation, municipal, industrial)

WELL COMPLETION DATA:

- (1) diameter (inches) 4
- (2) total depth (feet) 66
- (3) static water level (feet) 15 below top of ground
- (4) casing (material) plastic, (depth) 60, (size) 4 if telescope see back.
- (5) screen (length) 6, (depth to top) 60, (size) 4, (material) plastic
- (6) pump (HP) 1/2, (yield gpm) 10, (type power) electric
- (7) electric log (yes or no) no
- (organization running log)
- (8) how well bottom plugged (washed)


**CODED**

2-19-71

DRILLERS REMARKS:

If well telescopes please sketch and show depths.

GROUND LEVEL

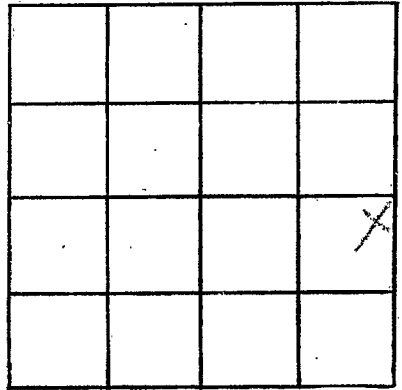

SECTION 29

Please indicate well location X.

ADDITIONAL INFORMATION

If more than one screen,  
show locations of each on sketch.