

WALTHALL MISSISSIPPI BOARD OF WATER COMMISSIONERS


D.4

4-13-66 CODED

WATER WELL DRILLERS LOG

Date: 4/13, 1966, Driller: T. B. Andrews County Walthall
 (Name)

	Description -& Color of Materials Sand, Clay, Red Clay, Shell, etc.	Thick- ness Feet	Depth Feet
(1) Owner of Land: <u>Walter Randall</u> (Name) <u>Rt. 1 Tyler town, Miss</u> (Address)	0' to 40' Red Clay		
(2) Location: <u>1/4</u> , <u>1/4</u> , Sec. <u>29 T3 R11</u> , <u>6</u> miles <u>N</u> of <u>Tyler town</u> (distance) (direction) (Nearest Town)	40' to 50' gravel	CODED	
(3) Topography: _____ (Hilly) (Flat) (Level)	50' to 75' Sand		
(4) Purpose of Well: _____ (Domestic, Irrigation, Municipal, Industrial, Other)	75' to 80' gravel		
Information upon completion of well:			
(1) Diameter <u>4</u> inches.	80' to 105' Sand		
(2) Total Depth <u>125</u> feet.	115' to 125' gravel	CODED	
(3) Water Level <u>75</u> feet below top of ground.			
(4) Cased to <u>119'</u> , Size <u>4"</u>			
(5) Screen: Size <u>4"</u> , Length <u>6"</u>			
(6) Were any formations sealed against pollution? _____ yes, <input checked="" type="checkbox"/> no.			
If YES depth of formation _____			
Why _____			
Drillers Remarks: <u>Plastic well</u>			Well No. <u>7</u>

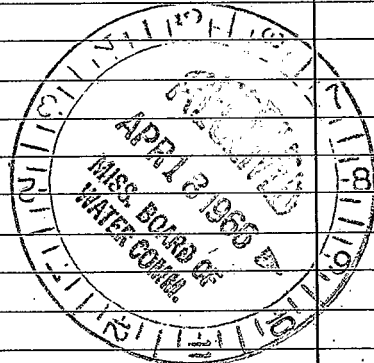

(Use Back Side)

