

WALTHAM MISSISSIPPI BOARD OF WATER COMMISSIONERS

D 5

4-26-66

CODED

WATER WELL DRILLERS LOG

Date: 4/26, 1966, Driller: T. B. Andrews County Waltham  
 (Name)

(1) Owner of Land: Jesse Smith  
 (Name)  
Rt. 1 Tyler town Miss.  
 (Address)

(2) Location: 1/4, 1/4, Sec. 29 T2 R11  
7 miles N of Tyler town  
 (distance) (direction) (Nearest Town)

(3) Topography: Hilly  
 (Hilly) (Flat) (Level)

(4) Purpose of Well: Domestic  
 (Domestic Irrigation  
 Municipal, Industrial, Other)

Description & Color of Materials Sand, Clay, Red Clay, Shell, etc.	Thick- ness Feet	Depth Feet
0' to 60' Red Clay		
60' to 70' GRAVEL		
70' to 100' Red Chalk		
100' to 150' Sandy Red Clay		
150' to 160' Sand / GRAVEL		

Information upon completion of well:

(1) Diameter 4 inches.

(2) Total Depth 160 feet.

(3) Water Level 100 feet below top of ground.

(4) Cased to 160', Size 4"

(5) Screen: Size \_\_\_\_\_, Length \_\_\_\_\_

(6) Were any formations sealed against pollution?  
 \_\_\_\_\_ yes,  no.


If YES depth of formation \_\_\_\_\_

Why \_\_\_\_\_

Drillers Remarks: \_\_\_\_\_

plastic well

CODED

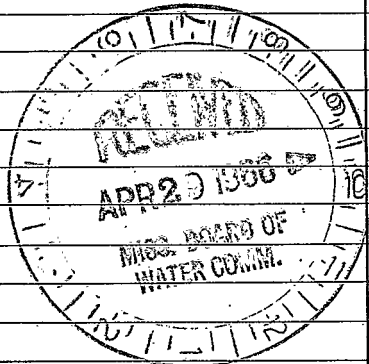

11

Well No.

(Use Back Side)

