

D 6
4-27-66 CODED

WATER WELL DRILLERS LOG

Date: 4/27, 1966, Driller: T. B. Andrews County Walthall
(Name)

(1) Owner of Land:	Description & Color of Materials	Thick-ness Feet	Depth Feet
<u>Rev. Mitchel Graves</u> (Name) <u>Rt. 1 Tyler town</u> (Address)	Sand, Clay, Red Clay, Shell, etc. <u>0' to 40'</u>		
(2) Location: <u>1/4</u> , <u>1/4</u> , Sec. <u>8</u> T <u>3</u> R <u>11</u> , <u>1</u> miles <u>N</u> , of <u>Salem</u> (distance) (direction) (Nearest Town)	<u>Sands & gravel</u>		
(3) Topography: <u>Flat</u> (Hilly) (Flat) (Level)			
(4) Purpose of Well: <u>Domestic</u> (Domestic Irrigation Municipal, Industrial, Other)			


Information upon completion of well:

- (1) Diameter 4 inches.
- (2) Total Depth 40 feet.
- (3) Water Level 15 feet below top of ground.
- (4) Cased to 40', Size 4"
- (5) Screen: Size _____, Length _____.
- (6) Were any formations sealed against pollution?
_____ yes, no.

If YES depth of formation _____
Why _____

Drillers Remarks:
4" plastic well

CODED

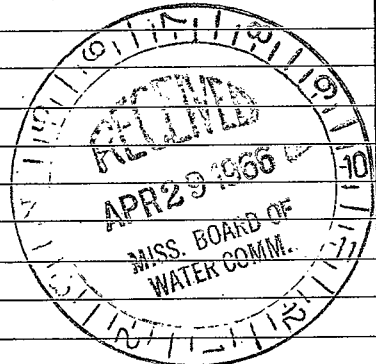

(Use Back Side)

12

Well No.

