

WALTHALL

D 7

6-2-66

WATER WELL DRILLERS LOG

Date: 6-2, 1966, Driller: E.B. SHEPARD County: WALTHALL

(Name)

- (1) Owner of Land: TDA Packwood  
(Name)
- Rt. 1 - TYLER TOWN, MISS.  
(Address)
- (2) Location: 1/4, 1/4, Sec. 13 T. 3N. R. 1E  
(distance) (direction) (Nearest Town)
- (3) Topography: V  
(Hilly) (Flat) (Level)
- (4) Purpose of Well: DOMESTIC  
(Domestic Irrigation, Municipal, Industrial, Other)

Description & Color of Materials Sand, Clay, Red Clay, Shell, etc.	Thick- ness Feet	Dep Fe
HARD GRAY CLAY	'	
SANDY SILT	35"	
HARD BLUE CLAY	45"	
COARSE HEAVY SAND	76"	
	88"	

Information upon completion of well:

- (1) Diameter 2 inches.
- (2) Total Depth 88 feet.
- (3) Water Level 38 feet below top of ground.
- (4) Cased to 88', Size 2"
- (5) Screen: Size 2", Length 3'
- (6) Were any formations sealed against pollution?  
\_\_\_\_\_ yes,  no.


If YES depth of formation \_\_\_\_\_

Why \_\_\_\_\_

Drillers Remarks: \_\_\_\_\_

CODED

CODED

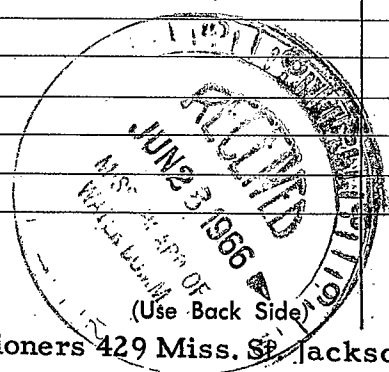

Well No.

