

Walthall

D9

11-66

MISSISSIPPI BOARD OF WATER COMMISSIONERS

WATER WELL DRILLERS LOG

CODED

Date: 10/9, 1966, Driller: T.B. Andrews County Walthall
(When well drilled) (Name) (Where well is located)

(1) Owner of Land: Von Beard
(Name)
Rt. 1 Tylertown, Miss
(Address)
(2) Location: SW 1/4, SW 1/4, Sec. 32 T3 R11E
5 miles N of Tylertown
(distance) (direction) (Nearest Town)
(3) Topography: Flat
(Hilly) (Flat) (Level)
(4) Purpose of Well: Domestic
(Domestic Irrigation
Municipal, Industrial, Other)

Table with 3 columns: Description & Color of Materials, Thickness Feet, Depth Feet. Contains handwritten entries: 'gray clay' and 'Sand / pea gravel' with thicknesses of 8' and 22' 30' respectively.

Information upon completion of well:

CODED


(1) Diameter 4 inches.
(2) Total Depth 30 feet.
(3) Water Level 8 feet below top of ground.
(4) Cased to 30', Size 4"
(5) Screen: Size 4", Length 6'
(6) Were any formations sealed against pollution?
yes, no.

If YES depth of formation

Why

Drillers Remarks:

Yield in gpm: Drilled and
Size pump: Cased well
Type power:

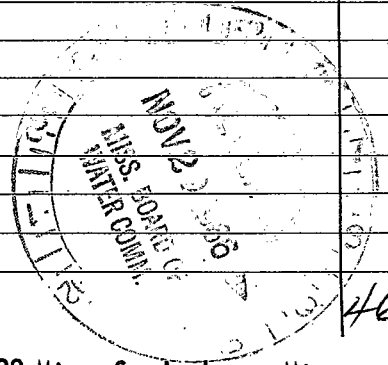

46

