

Walthall
D10
1-67

MISSISSIPPI
BOARD OF WATER COMMISSIONERS
416 North State Street
Jackson, Mississippi 39201

WATER WELL DRILLERS LOG

1-11-19 date well completed
67 Fitzgerald Water Well Serv firm name
Walthall county well located

LANDOWNER: DO Toney
Tylertown Rt Miss
(mailing address)


WELL LOCATION:
sec. 33 T. 30 N. R. 11 E
607 miles N of Tylertown
(distance) (direction) (nearest town)

WELL PURPOSE: FISH HOUSE
(home, irrigation, municipal, industrial)

- WELL COMPLETION DATA:
- (1) diameter (inches) 4
 - (2) total depth (feet) 41
 - (3) static water level (feet) 10 below top of ground.
 - (4) casing plastic 36 (material) (depth)
 - 4 (size) if telescope see back.
 - (5) screen 5, 36 (length) (depth to top)
 - 4, plastic (size) (material)
 - (6) pump 1/2 hp 15 (HP) (yield gpm)
 - Elec (type power)
 - (7) electric log No (yes or no)
 - (organization running log)
 - (8) how well bottom plugged Wedd bag

description of formations encountered	from	to
Topsoil & clay	0	6
Chalk		15
sand & gravel		41
Chalk		41


CODED

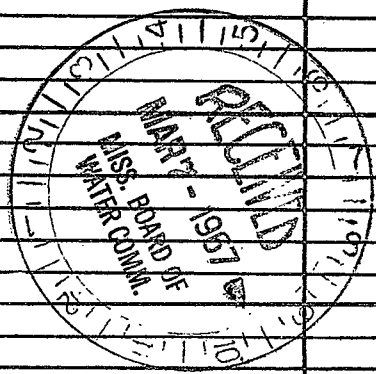

DRILLERS REMARKS:

If well telescopes please sketch and show depths.

GROUND LEVEL

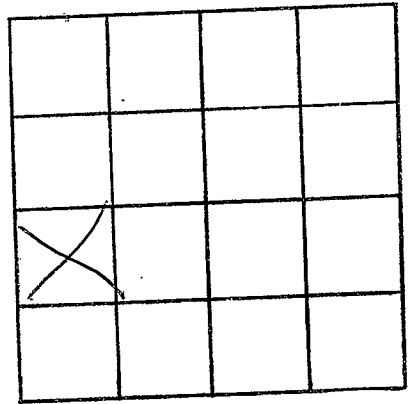

SECTION 33

Please indicate well location X.

ADDITIONAL INFORMATION

If more than one screen, show locations of each on sketch.