

Walshall
D 13
8-67

MISSISSIPPI
BOARD OF WATER COMMISSIONERS
416 North State Street
Jackson, Mississippi 39201

WATER WELL DRILLERS LOG

8/30 1967 date well completed
Andrus Drilling Co. firm name
Walshall county well located

CODED

LANDOWNER: E.R. Ross
Pt. 3 Jayess
Miss.
(mailing address)

description of formations encountered	from	to
Red Clay	0'	40'
Gravel	40'	60'
Coarse Sand (fine gravel)	60'	80'

WELL LOCATION:
sec. 28 T. 3 N. R. 11 E
13 miles N.E. of Tubertown
(distance) (direction) (nearest town)

WELL PURPOSE: Home
(home, irrigation, municipal, industrial)

WELL COMPLETION DATA:

(1) diameter (inches) 4"

(2) total depth (feet) 80'

(3) static water level (feet) 50 below top of ground.

(4) casing P.V.C. 74' (material) (depth)
4" (size) if telescope see back.

(5) screen 6' 80' (length) (depth to top)
4" P.V.C. (size) (material)

(6) pump 3/4 10 (HP) (yield gpm)
R.Ed 220 (type power)

(7) electric log no (yes or no)
(organization running log)

(8) how well bottom plugged Rock
WASH VALVE


CODED



DRILLERS REMARKS:

If well telescopes please sketch and show depths.

GROUND LEVEL

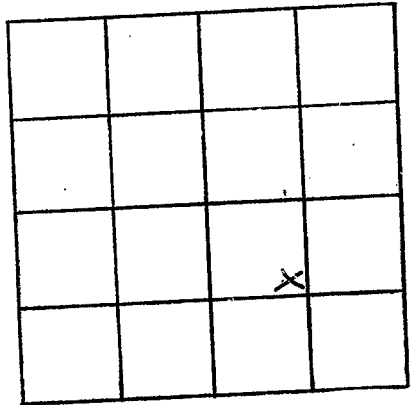

SECTION 28

Please indicate well location X.

ADDITIONAL INFORMATION

If more than one screen, show locations of each on sketch.