

Walthall
 D 14
 8-67

MISSISSIPPI
 BOARD OF WATER COMMISSIONERS
 416 North State Street
 Jackson, Mississippi 39201

WATER WELL DRILLERS LOG

Aug 28 1967 Fitzgerald Well Service Walthall
 date well completed firm name county well located

CODED

CODED

LANDOWNER: Henry Osborn

description of formations encountered	from	to
<u>Red clay</u>	<u>0</u>	<u>20</u>
<u>Red sand</u>	<u>20</u>	<u>80</u>
<u>Coarse sand & gravel</u>	<u>80</u>	<u>101</u>

Parcel Route Tyler (mailing address)

WELL LOCATION:
 sec 16 T 3 N R 11 E
5 W
10 miles NNE of Tyler
 (distance) (direction) (nearest town)

WELL PURPOSE: Home
 (home, irrigation, municipal, industrial)


- WELL COMPLETION DATA:
- (1) diameter (inches) 4"
 - (2) total depth (feet) 101'
 - (3) static water level (feet) 83' below top of ground.
 - (4) casing Plastic, 95' (material) (depth)
4" if telescope see back. (size)
 - (5) screen 6', 95' (length) (depth to top)
4", Plastic (size) (material)
 - (6) pump ?, ? (HP) (yield gpm)
Electric (type power)
 - (7) electric log no (yes or no)
 (organization running log)
 - (8) how well bottom plugged Wood plug

DRILLERS REMARKS:



If well telescopes please sketch and show depths.

GROUND LEVEL

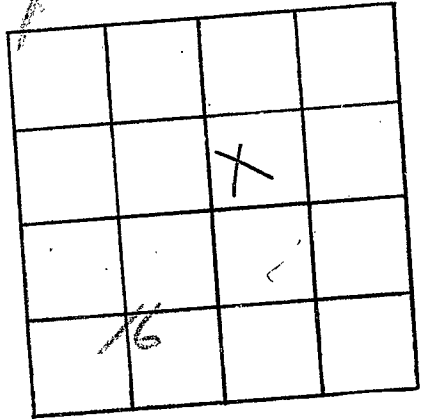

SECTION 16

Please indicate well location X.

ADDITIONAL INFORMATION

Multiple horizontal lines for entering additional information.

If more than one screen, show locations of each on sketch.