

Walshall
D15
11-67

MISSISSIPPI
BOARD OF WATER COMMISSIONERS
416 North State Street
Jackson, Mississippi 39201

WATER WELL DRILLERS LOG

11-30 1967 Fitzgerald Water Well Walshall -
date well completed firm name county well located

LANDOWNER: Bud Spence
Tylertown Rt Miss

description of formations encountered	from	to
Top soil / clay	0	12
Gravel / sand	12	35
White Chalk	35	95
Sand	95	109
Coarse sand - gravel	103	113

(mailing address)


WELL LOCATION:
sec. 18 T 3 N R 11 E S W
0.7 miles N of Tylertown
(distance) (direction) (nearest town)

WELL PURPOSE: Home
(home, irrigation, municipal, industrial)

WELL COMPLETION DATA:

- (1) diameter (inches) 4
- (2) total depth (feet) 113
- (3) static water level (feet) 95 below top of ground.
- (4) casing plastic, 109 (material) (depth)
4 (size) if telescope see back.
- (5) screen 6' 109 (length) (depth to top)
4" plastic (size) (material)
- (6) pump (HP) (yield gpm)
Elec (type power)
- (7) electric log No (yes or no)
(organization running log)
- (8) how well bottom plugged Wood peg

CODED

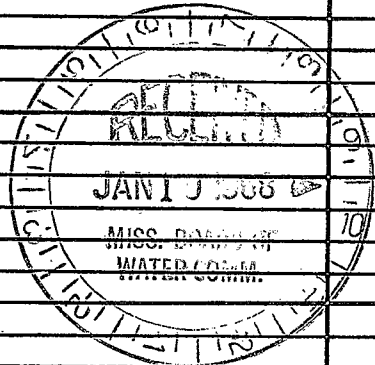

DRILLERS REMARKS:

If well telescopes please sketch and show depths.

GROUND LEVEL

		X	

SECTION 18

Please indicate well location X.

ADDITIONAL INFORMATION

If more than one screen, show locations of each on sketch.