

Walthall
D 17
3-2-67

MISSISSIPPI
BOARD OF WATER COMMISSIONERS
416 North State Street
Jackson, Mississippi 39201

WATER WELL DRILLERS LOG

March 2 1967 ^{CODED} ~~James & Elbert Brown~~ Walthall
date well completed firm name county well located

LANDOWNER:
Sherry Fulgum
Rt. 5, Sylva
(mailing address)

description of formations encountered	from	to
RED CLAY	0	4.5
White CLAY-FINE SAND	4.5	7.5
SAND	7.5	9.0
GRAVEL	9.0	11.2

WELL LOCATION:
sec. 15 T. 30 N. R. 11 E. S. 11
2 miles of Sylva
(distance) (direction) (nearest town)

WELL PURPOSE: HOME
(home, irrigation, municipal, industrial)

WELL COMPLETION DATA:

(1) diameter (inches) 4"

(2) total depth (feet) 112

(3) static water level (feet) 80 ^{below} top of ground.

(4) casing PLASTIC, 102 (material) (depth)
4" (size) If telescope see back.


(5) screen 5' 107 (length) (depth to top)
4" PLASTIC (size) (material)

(6) pump 1 HP 5 GPM (HP) (yield gpm)
Elec (type power)

(7) electric log NO (yes or no)

(organization running log)

CODED

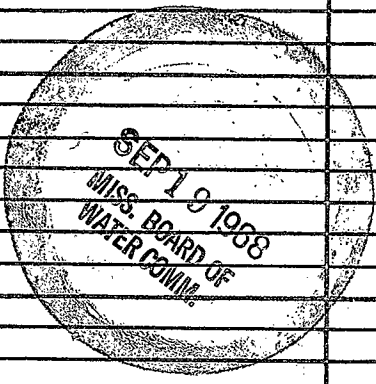


(8) how well bottom plugged W.P.

DRILLERS REMARKS: 2 PIPE
Jet Pump
1 1/2" + 1"

If well telescopes please sketch and show depths.

GROUND LEVEL

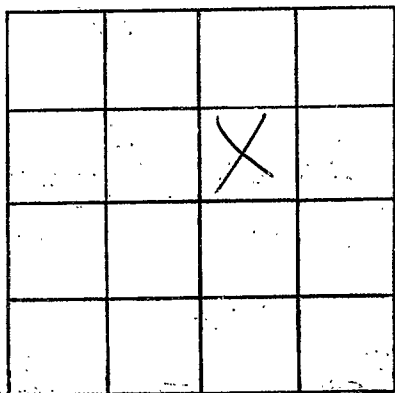

SECTION 15

Please indicate well location X.

ADDITIONAL INFORMATION

If more than one screen, show locations of each on sketch.