

**CODED**

MISSISSIPPI  
BOARD OF WATER COMMISSIONERS  
416 North State Street  
Jackson, Mississippi 39201

Walthall  
D18  
3-10-67

67 WATER WELL DRILLERS LOG

March 10 1967 Fennie + Elbert Brown WALTHALL  
date well completed firm name county well located

LANDOWNER:

RUFUS RUSHING  
RT 5, TYLETOWN  
(mailing address)

description of formations encountered

from to

Red CLAY	0	35
SAND	35	63
SAND & GRAVEL	63	80
White CLAY	80	105
Blue CLAY	105	150
SAND	150	170
GRAVEL	170	184

WELL LOCATION:

sec. 10 T. 30 N R. 11 E  
S W  
2 miles E of SALEM  
(distance) (direction) (nearest town)


WELL PURPOSE:

Home  
(home, irrigation, municipal, industrial)

WELL COMPLETION DATA:

- (1) diameter (inches) 2"
- (2) total depth (feet) 184'
- (3) static water level (feet) 78' below top of ground.
- (4) casing GALV 184' (material) (depth)  
2" (size) If telescope see back.
- (5) screen 5' 179' (length) (depth to top)  
2" 5.5. (size) (material)
- (6) pump 1/2 4 GPM (HP) (yield gpm)  
Elect (type power)
- (7) electric log \_\_\_\_\_ (yes or no)  
\_\_\_\_\_ (organization running log)
- (8) how well bottom plugged BWV

**CODED**

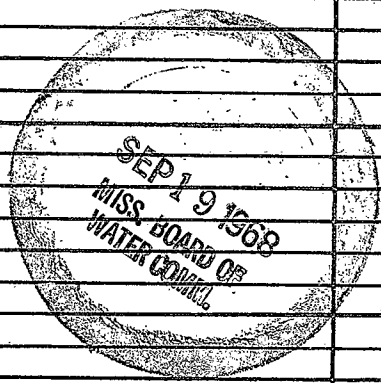


DRILLERS REMARKS:

ROD TYPE PUMP

If well telescopes please sketch and show depths.

GROUND LEVEL

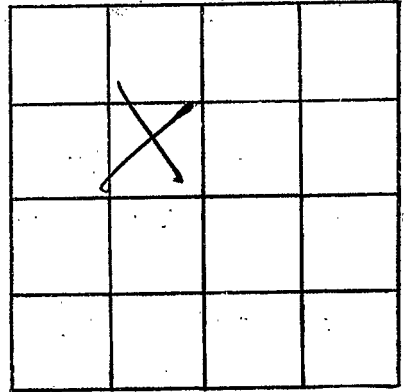

SECTION 10

Please indicate well location X.

ADDITIONAL INFORMATION

If more than one screen,  
show locations of each on sketch.