

Walthall
 D 19
 5-14-67

MISSISSIPPI
 BOARD OF WATER COMMISSIONERS
 416 North State Street
 Jackson, Mississippi 39201

WATER WELL DRILLERS LOG

5-14 1967 *Fernes & McPherson* Walthall
 date well completed firm name county well located

LANDOWNER:
Marnie Rushing
Dylertown Miss
 (mailing address)


description of formations encountered	from	to
Red clay	0	30
Sand	30	65
Gravel	65	88

WELL LOCATION:
 sec. 31 T. 3 N. R. 11 E.
5 miles N of Dylertown
 (distance) (direction) (nearest town)

WELL PURPOSE: None
 (home, irrigation, municipal, industrial)

- WELL COMPLETION DATA:
- (1) diameter (inches) 4
 - (2) total depth (feet) 88
 - (3) static water level (feet) 65 below above top of ground.
 - (4) casing Plate 8.3
 (material) (depth)
 (size) If telescope see back.
 - (5) screen 5 4
 (length) (depth to top)
 (size) (material)
 - (6) pump 1 6
 (HP) (yield gpm)
Elec
 (type power)
 - (7) electric log no
 (yes or no)
 (organization running log)
 - (8) how well bottom plugged WV


CODED

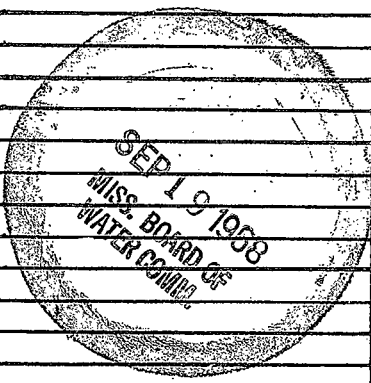

DRILLERS REMARKS:

If well telescopes please sketch and show depths.

GROUND LEVEL

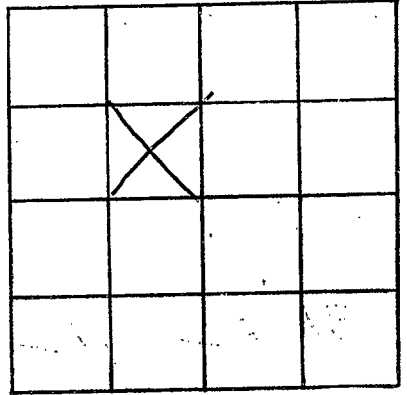

SECTION 31

Please indicate well location X.

ADDITIONAL INFORMATION

Lined area for additional information.

If more than one screen, show locations of each on sketch.