

Walthall
D 20
7-7-67

MISSISSIPPI
BOARD OF WATER COMMISSIONERS
416 North State Street
Jackson, Mississippi 39201

WATER WELL DRILLERS LOG

July 7, 1967 lot Fernie + Elbert Brown WALTHALL
date well completed firm name county well located

LANDOWNER:
John P. Brock

(mailing address)

description of formations encountered	from	to
Red Clay	0	20
SAND	20	50
SAND + GRAVEL	50	60

WELL LOCATION:
sec. 24 T. 30 N. R. 11 E
7 miles NE of TYLER TOWN
(distance) (direction) (nearest town)


WELL PURPOSE: Home
(home, irrigation, municipal, industrial)

- WELL COMPLETION DATA:
- (1) diameter (inches) 4"
 - (2) total depth (feet) 60'
 - (3) static water level (feet) 38' ^{below} top of ground.
 - (4) casing PLASTIC, 60'
(material), (depth)
4" if telescope see back.
(size)
 - (5) screen 5', 55'
(length), (depth to top)
4", PLASTIC
(size), (material)
 - (6) pump _____
(HP) (yield gpm)

(type power) _____
 - (7) electric log _____
(yes or no)

(organization running log) _____
 - (8) how well bottom plugged W V


CODED

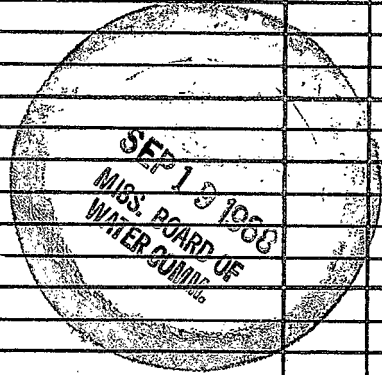

DRILLERS REMARKS: NO PUMP - USE ROPE + BUCKET

If well telescopes please sketch and show depths.

GROUND LEVEL

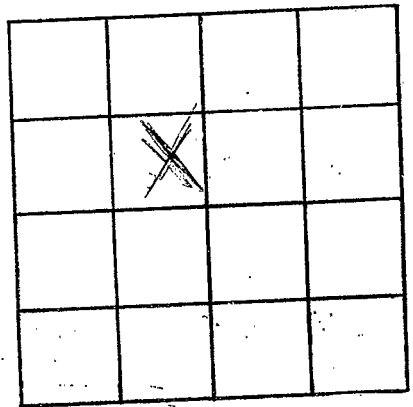

SECTION 24

Please indicate well location X.

ADDITIONAL INFORMATION

If more than one screen, show locations of each on sketch.