

Walthall  
 D 21  
 7-12-67

CODED

MISSISSIPPI  
 BOARD OF WATER COMMISSIONERS  
 416 North State Street  
 Jackson, Mississippi 39201

WATER WELL DRILLERS LOG

July 12 1967 Fernie + Elbert Brown Walthall  
 date well completed firm name county well located

LANDOWNER:  
Mrs. Recie Bracey  
 (mailing address)

description of formations encountered	from	to
CLAY	0	45
GRAVEL	45	50
CLAY	50	73
SAND + GRAVEL	73	88

WELL LOCATION:  
 sec. 13 T. 3 N. R. 110 E  
8 miles NE of Tyletown  
 (distance) (direction) (nearest town)

CODED

WELL PURPOSE: Home  
 (home, irrigation, municipal, industrial)

WELL COMPLETION DATA:

(1) diameter (inches) 4"

(2) total depth (feet) 88'

(3) static water level (feet) 45' below top of ground.


(4) casing PLASTIC, 88'  
 (material) (depth)  
4" if telescope see back.  
 (size)

(5) screen 5', 83'  
 (length) (depth to top)  
4", PLASTIC  
 (size) (material)

(6) pump 1 HP, 6  
 (HP) (yield gpm)  
Elect  
 (type power)

(7) electric log \_\_\_\_\_  
 (yes or no)  
 \_\_\_\_\_  
 (organization running log)


(8) how well bottom plugged W U

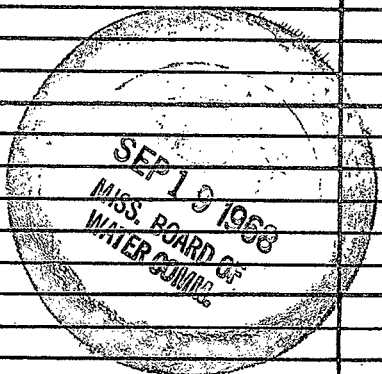

DRILLERS REMARKS: Jet Pump

If well telescopes please sketch and show depths.

GROUND LEVEL

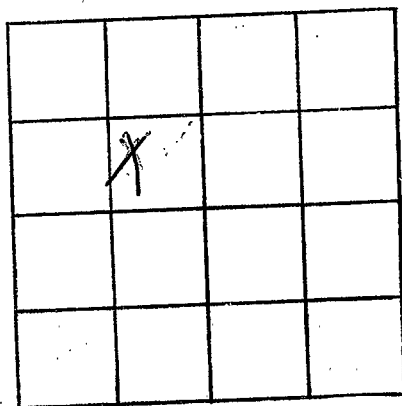

SECTION 13

Please indicate well location X.

ADDITIONAL INFORMATION

If more than one screen, show locations of each on sketch.