

Walthall
D 22
3-8-68

CODED
MISSISSIPPI
BOARD OF WATER COMMISSIONERS
416 North State Street
Jackson, Mississippi 39201

⁶⁷ WATER WELL DRILLERS LOG

March 8 1968 *Fernie + Ellet Brown* - *Walthall*
date well completed firm name county well located

LANDOWNER:
HENDERSON RUSHING
RT 5, TYLEETOWN
(mailing address)

description of formations encountered	from	to
<i>Red CLAY</i>	<i>0</i>	<i>23</i>
<i>Red SANDY CLAY</i>	<i>7-5</i>	<i>4-5</i>
<i>SAND</i>	<i>15</i>	<i>23</i>
<i>GRAVEL</i>	<i>23</i>	<i>96</i>


WELL LOCATION:
sec. *10* T. *30* N. R. *110* E
S W
2 miles *E* of *SALEM*
(distance) (direction) (nearest town)

WELL PURPOSE: *HOME*
(home, irrigation, municipal, industrial)

- WELL COMPLETION DATA:
- (1) diameter (inches) *4"*
 - (2) total depth (feet) *96*
 - (3) static water level (feet) *78* below top of ground. ^{above}
 - (4) casing *PLASTIC* *96'*
(material) (depth)
4" if telescope see back.
(size)
 - (5) screen *5'* *91'*
(length) (depth to top)
4" *PLASTIC*
(size) (material)
 - (6) pump *3/4* *0 GPM*
(HP) (yield gpm)
ELECT
(type power)
 - (7) electric log
(yes or no)


(organization running log)
 - (8) how well bottom plugged *B.W.V.*

DRILLERS REMARKS: *2 PIPE*
1 1/4" & 1"

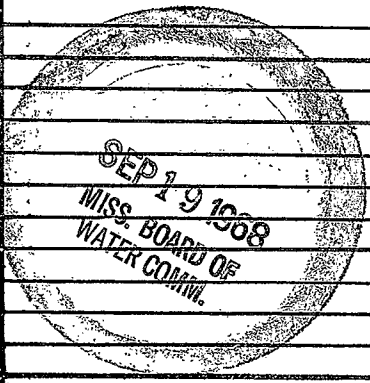

If well telescopes please sketch and show depths.

GROUND LEVEL

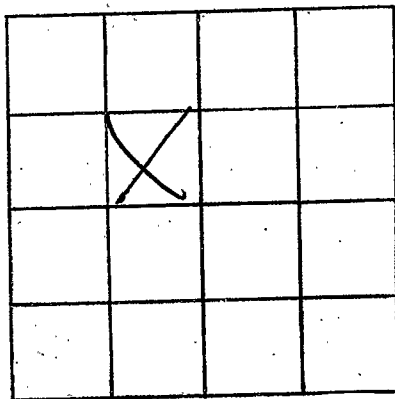

SECTION 10

Please indicate well location X.

ADDITIONAL INFORMATION

If more than one screen,
show locations of each on sketch.