

CODED

CODED

MISSISSIPPI BOARD OF WATER COMMISSIONERS
416 North State Street
Jackson, Mississippi 39201

WATER WELL DRILLERS LOG

Waethall
D 23
12-13-68

Dec-13 1968 J.T. Construction WAETHALL
date well completed firm name county well located

LANDOWNER: Elmer Howell

description of formations encountered from to

(mailing address)

WELL LOCATION:

sec 27 T 3 N R 11 E
35 S W
10 miles North of Telectown
(distance) (direction) (nearest town)

WELL PURPOSE: Home
(home, irrigation, municipal, industrial)

WELL COMPLETION DATA:

- (1) diameter (inches) 4"
- (2) total depth (feet) 75'
- (3) static water level (feet) 60' below top of ground.
- (4) casing Plastic, 79' (material) (depth)
(size) If telescope see back.
- (5) screen 6' (length), 75' (depth to top)
4" (size), Plastic (material)
- (6) pump 1 (HP), 7 (yield gpm)
A.C. (type power)
- (7) electric log (yes or no)
- (organization running log)
- (8) how well bottom plugged not well

CODED


JAN 28 1969

DRILLERS REMARKS:

MISS. BD. OF WATER COMM.

If well telescopes please sketch and show depths.

GROUND LEVEL

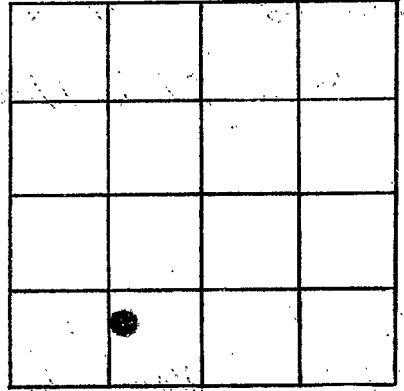

SECTION 27

Please indicate well location X.

ADDITIONAL INFORMATION

If more than one screen, show locations of each on sketch.