

Walshall  
D 2 A  
2-27-69

MISSISSIPPI  
BOARD OF WATER COMMISSIONERS  
416 North State Street  
Jackson, Mississippi 39201

CODED  
CODED

WATER WELL DRILLERS LOG

Feb 27 1969 Figg, Michael L Walshall  
date well completed firm name county well located

LANDOWNER:  
Dr. J. C. Luter  
RR. Tylertown, Miss.  
(mailing address)

description of formations encountered	from	to
red clay	0	20
red sand & gravel	20	80
red shale	80	90
Coarse sand & gravel	90	110

WELL LOCATION:  
sec 20 T 3 N R 11 E  
S W  
6 miles N of Tylertown  
(distance) (direction) (nearest town)

WELL PURPOSE: Home  
(home, irrigation, municipal, industrial)

WELL COMPLETION DATA:

(1) diameter (inches) 4

(2) total depth (feet) 110

(3) static water level (feet) 75 below top of ground.

(4) casing: plastic, 104 (material) (depth)  
4 (size) if telescope see back.

(5) screen: 6, 104 (length) (depth to top)  
4 (size) plastic (material)

(6) pump: 1 (HP) 97 (yield gpm)  
elec (type power)

(7) electric log no (yes or no)  
(organization running log)

CODED

(8) how well bottom plugged 6200 ft


MAR 13 1969

DRILLERS REMARKS:

MISS. BD. OF  
WATER COMMISSIONERS

If well telescopes please sketch and show depths.

GROUND LEVEL

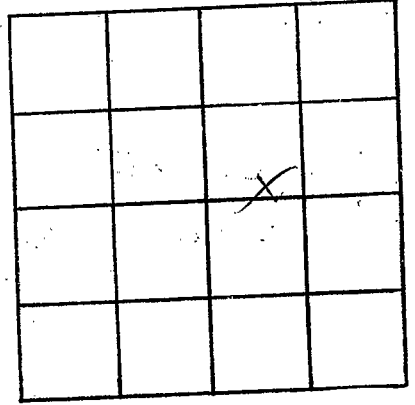

SECTION 20

Please indicate well location X.

ADDITIONAL INFORMATION

If more than one screen, show locations of each on sketch.