

CODED

MISSISSIPPI BOARD OF WATER COMMISSIONERS
416 North State Street
Jackson, Mississippi 39201

Walthall
D 25
7-69

WATER WELL DRILLERS LOG

July 11, 1969 date well completed
Easter Stafford firm name
Walthall county well located

LANDOWNER: East Linn Hill Church
Rt. 5
Tylertown, Miss.
(mailing address)

description of formations encountered	from	to
Red sand + Chalk	0'	95'
Sand & Gravel	95'	124'

WELL LOCATION:
sec. 15 T. 2 N. R. 11 E
15 miles N of Tylertown
(distance) (direction) (nearest town)

WELL PURPOSE:
(home, irrigation, municipal, industrial)

- WELL COMPLETION DATA:
- (1) diameter (inches) 4"
 - (2) total depth (feet) 124'
 - (3) static water level (feet) 95' below top of ground.
 - (4) casing 1 1/2" (material) 118' (depth)
(size) if telescope see back.
 - (5) screen 10' (length) 118' (depth to top)
4" (size) Plastic (material)
 - (6) pump 3/4 HP (HP) 300 gpm (yield gpm)
 - (type power)
 - (7) electric log No (yes or no)
 - (organization running log)
 - (8) how well bottom plugged B.W.V.


DRILLERS REMARKS:

PAGE 7 369

MISS. Bd. WATER COM.

If well telescopes please sketch and show depths.

GROUND LEVEL

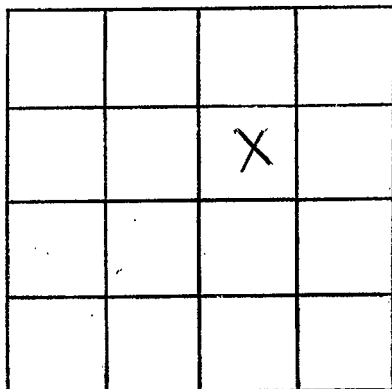

SECTION _____

Please indicate well location X.

ADDITIONAL INFORMATION

If more than one screen, show locations of each on sketch.