

MISSISSIPPI  
BOARD OF WATER COMMISSIONERS  
416 North State Street  
Jackson, Mississippi 39201

CODED

WATER WELL DRILLERS LOG

Walshall  
D 76  
10-24-69

01-24-69 date well completed  
69 Renew Well Pump Co - Walshall firm name  
Walshall county well located

LANDOWNER: Donald  
Bullman  
Rt-1, Tylertown  
(mailing address)

description of formations encountered	from	to
Red clay	0	18
Red sand & chalk	18	61
Small gravel band	61	72
White & blue chalk	72	106
Red gravel band	106	122

WELL LOCATION:  
sec. 16 T 3 N R 4 E  
4 miles, ONE of Tylertown  
(distance) (direction) (nearest town)

WELL PURPOSE: Home  
(home, irrigation, municipal, industrial)

WELL COMPLETION DATA:

(1) diameter (inches) 4"

(2) total depth (feet) 122'

(3) static water level (feet) 66' below top of ground

(4) casing Plastic bottom  
(material) (depth)

(size) if telescope see back.

(5) screen 6' 116'  
(length) (depth to top)

4" Plastic  
(size) (material)

(6) pump 1/2 sub-12  
(HP) (yield gpm)

Electric  
(type power)

(7) electric log NO  
(yes or no)

(organization running log)

(8) how well bottom plugged  
water plug


DRILLERS REMARKS:  
old well hole

DEC 31 1969

MISS. BD. OF  
WATER COMMISSIONERS

If well telescopes please sketch and show depths.

GROUND LEVEL

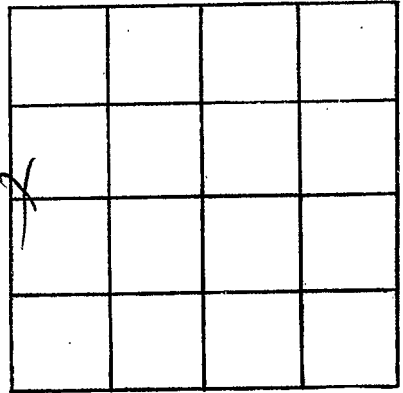

SECTION 16

Please indicate well location X.

ADDITIONAL INFORMATION

If more than one screen,  
show locations of each on sketch.