

Walthall  
D 29  
1-23-70

MISSISSIPPI  
BOARD OF WATER COMMISSIONERS  
416 North State Street  
Jackson, Mississippi 39201  
WATER WELL DRILLERS LOG

CODED


1-23 1970 Fitzgualdell Luter Walthall  
date well completed firm name county well located

LANDOWNER:	description of formations encountered	from	to
<u>Dub McKenzie</u>			
<u>RR. Tylertown, Miss.</u> (mailing address)	<u>Red clay</u>	<u>0</u>	<u>20</u>
WELL LOCATION:	<u>Red gravel</u>	<u>20</u>	<u>35</u>
sec. <u>16</u> T <u>3</u> N R <u>1</u> E	<u>Red sand</u>	<u>35</u>	<u>80</u>
<u>5</u> miles <u>N</u> of <u>Tylertown</u> (distance) (direction) (nearest town)	<u>Coarse sand &amp; gravel</u>	<u>80</u>	<u>95</u>
WELL PURPOSE: <u>Home</u> (home, irrigation, municipal, industrial)			
WELL COMPLETION DATA:			
(1) diameter (inches) <u>4</u>			
(2) total depth (feet) <u>95</u>			
(3) static water level (feet) <u>40</u> below above top of ground.			
(4) casing <u>plastic</u> , <u>87</u> (material) (depth)			
<u>4</u> if telescope see back. (size)			
(5) screen <u>8</u> , <u>87</u> (length) (depth to top)			
<u>4</u> , <u>plastic</u> (size) (material)			
(6) pump <u>1/2</u> , <u>10</u> (HP) (yield gpm)			
<u>Ch</u> (type power)			
(7) electric log <u>no</u> (yes or no)			
(organization running log)			
(8) how well bottom plugged <u>wood peg</u>			
DRILLERS REMARKS:			

FREE  
65 27 1970  
MISS. Bd. OF  
WATER COMMISSIONERS

If well telescopes please  
sketch and show depths.

GROUND LEVEL

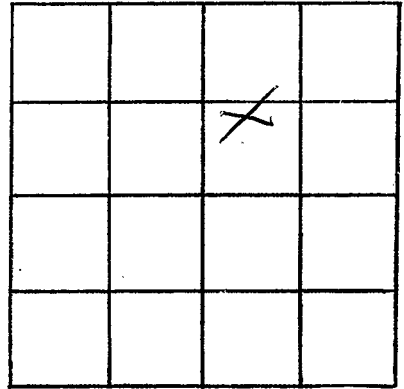

SECTION 16

Please indicate well location X.

ADDITIONAL INFORMATION

If more than one screen,  
show locations of each on sketch.