

Walthall
D30
4-25-70

MISSISSIPPI
BOARD OF WATER COMMISSIONERS
416 North State Street
Jackson, Mississippi 39201

CODED

WATER WELL DRILLERS LOG

april 25 1970 to F. J. Walthall
date well completed firm name county well located

LANDOWNER:
Willie Boyd
RR. Tylabon, Miss.
(mailing address)

description of formations encountered	from	to
Red clay	0	10
Red soil	10	30
Loose sand gravel	30	60

WELL LOCATION:
sec. 32 T 3 N R 11 E
3 miles N of Tylabon
(distance) (direction) (nearest town)

WELL PURPOSE: none
(home, irrigation, municipal, industrial)

- WELL COMPLETION DATA:
- (1) diameter (inches) 4
 - (2) total depth (feet) 60
 - (3) static water level (feet) 16 below above top of ground.
 - (4) casing 4" (material) 52' (depth)
4" if telescope see back. (size)
 - (5) screen 8" (length) 52' (depth to top)
4" (size) (material)
 - (6) pump 1/2 (HP) 3 (yield gpm)
(type power)
 - (7) electric log yes (yes or no)
(organization running log)
 - (8) how well bottom plugged good

CODED


APR 29 1970

DRILLERS REMARKS:

MISS. RD. 85
WATER COMMISSIONERS

If well telescopes please sketch and show depths.

GROUND LEVEL

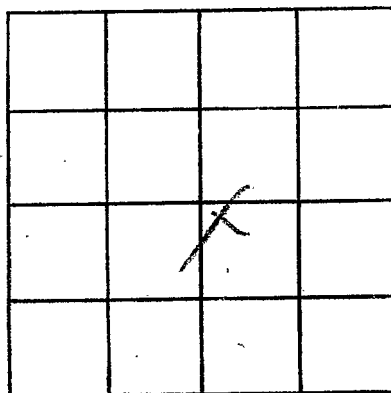

SECTION 32

Please indicate well location X.

ADDITIONAL INFORMATION

If more than one screen, show locations of each on sketch.