

WALTHALL
D 31
8-31-70

MISSISSIPPI
BOARD OF WATER COMMISSIONERS
416 North State Street
Jackson, Mississippi 39201

CODED

WATER WELL DRILLERS LOG

8-31 1970 F. J. Gould Well Co. Walthall
date well completed firm name county well located

LANDOWNER:
Mrs. Amy Bumpall
P.R. Fyfe, Miss
(mailing address)

description of formations encountered	from	to
<u>Red clay</u>	<u>0</u>	<u>20</u>
<u>Red sand</u>	<u>20</u>	<u>60</u>
<u>Coarse sand & gravel</u>	<u>60</u>	<u>99</u>

WELL LOCATION:
sec. 16 T. 3 N. R. 11 E
S. 6 miles N of Fyfe
(distance) (direction) (nearest town)

WELL PURPOSE: Home
(home, irrigation, municipal, industrial)

WELL COMPLETION DATA:

(1) diameter (inches) 4

(2) total depth (feet) 99

(3) static water level (feet) 55 below above top of ground.

(4) casing Plastic 91
(material) (depth)
4 if telescope see back.
(size)

(5) screen 8 91
(length) (depth to top)

4 Plastic
(size) (material)

(6) pump 3/4 5
(HP) (yield gpm)

Electric
(type power)

(7) electric log no
(yes or no)

(organization running log)

(8) how well bottom plugged well


CODED

DRILLERS REMARKS:

SEP 14 1970

If well telescopes please sketch and show depths.

GROUND LEVEL

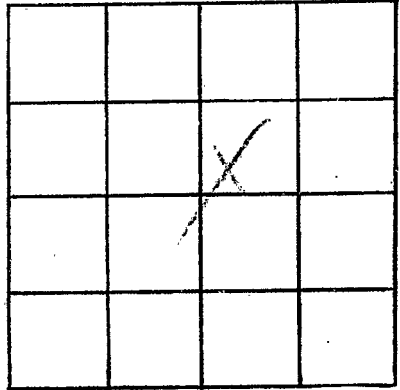

SECTION 16

Please indicate well location X.

ADDITIONAL INFORMATION

If more than one screen, show locations of each on sketch.