

WALTHALL

D32

7-27-70

MISSISSIPPI BOARD OF WATER COMMISSIONERS
416 North State Street
Jackson, Mississippi 39201

CODED

WATER WELL DRILLERS LOG

July 27, 1970 date well completed
Chester Lewis Walthall firm name
county well located

LANDOWNER:

Dale Sims

description of formations encountered

from

to

RTF -
Tylerstown
(mailing address)

@ clay
sand & gravel 0 8
chalk-sand & gravel 8 50
sand & pea gravel 50 62
62 89

WELL LOCATION:

sec. 18 T. 3 N. R. 11 E.
6 miles N Tylerstown
(distance) (direction) (nearest town)

WELL PURPOSE:

Home -
(home, irrigation, municipal, industrial)

WELL COMPLETION DATA:

- (1) diameter (inches) 4 1/2"
- (2) total depth (feet) 89
- (3) static water level (feet) below top of ground.
- (4) casing Plastic Bottom (material) (depth)
- (5) screen 6' 83' (length) (depth to top)
4" Plastic (size) (material)
- (6) pump 3/4 HP 10 (HP) (yield gpm)
Steel (type power)
- (7) electric log NO (yes or no)

CODED

(organization running log)

(8) how well bottom plugged

wooden plug

DRILLERS REMARKS:


New location

OCT 14 1970

MISS. BD. OF WATER COMM.

If well telescopes please sketch and show depths.

GROUND LEVEL

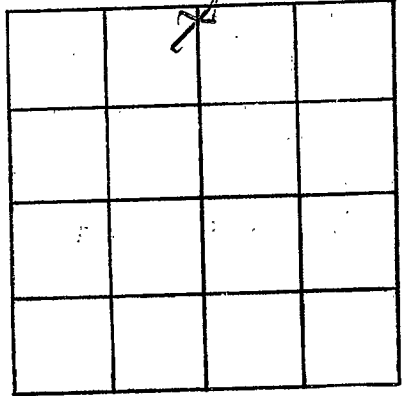

SECTION *28*

Please indicate well location X.

ADDITIONAL INFORMATION

If more than one screen, show locations of each on sketch.