

WALTHALL
D33
3-16-71

MISSISSIPPI
BOARD OF WATER COMMISSIONERS
416 North State Street
Jackson, Mississippi 39201

CODED

WATER WELL DRILLERS LOG

3-16 1971 Hygeine well Walthall
date well completed firm name county well located

LANDOWNER:
Mac Subles
R.R. Tylston
(mailing address)
WELL LOCATION:
sec. 30T 30 R 11E
7 miles N of Tylston
(distance) (direction) (nearest town)

WELL PURPOSE:
(home, irrigation, municipal, industrial)
Home

- WELL COMPLETION DATA:
- (1) diameter (inches) 4
 - (2) total depth (feet) 123
 - (3) static water level (feet) 78 below above top of ground.
 - (4) casing plastic, 117,
(material) (depth)
4 if telescope see back.
(size)
 - (5) screen 6, 117
(length) (depth to top)
4, plastic
(size) (material)
 - (6) pump 1/2, 10
(HP) (yield gpm)
6.0
(type power)
 - (7) electric log no
(yes or no)
(organization running log)
 - (8) how well bottom plugged good

description of formations encountered	from	to
<u>Red clay</u>	<u>0</u>	<u>20</u>
<u>White clay</u>	<u>20</u>	<u>110</u>
<u>Course sand ground</u>	<u>110</u>	<u>123</u>

CODED


MAR 31 1971

DRILLERS REMARKS:

MISS. BD. OF
WATER COMM.

If well telescopes please sketch and show depths.

GROUND LEVEL

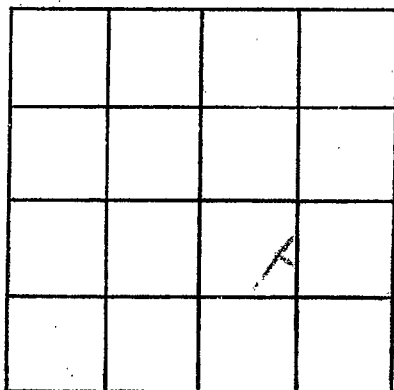

SECTION 20

Please indicate well location X.

ADDITIONAL INFORMATION

If more than one screen,
show locations of each on sketch.