

WALTHALL

D34

5-5-71

MISSISSIPPI BOARD OF WATER COMMISSIONERS  
416 North State Street  
Jackson, Mississippi 39201

**CODED**

WATER WELL DRILLERS LOG

5-5  
date well completed

1971 *Flynn & Co. Inc.*  
firm name

*Walthall*  
county well located

LANDOWNER:

*Simon Billman*  
*R.R. Foxworth, Jr.*  
(mailing address)

description of formations encountered

from to

<i>Red Clay</i>	<i>0</i>	<i>20</i>
<i>Red Sand</i>	<i>20</i>	<i>40</i>
<i>White Chalk</i>	<i>40</i>	<i>135</i>
<i>Thin sand</i>	<i>135</i>	<i>145</i>
<i>Coarse sandstone</i>	<i>145</i>	<i>155</i>

WELL LOCATION:

sec. 1 T 30 N R 11 E  
S W  
1 miles S of Osborne  
(distance) (direction) (nearest town)

WELL PURPOSE: Home  
(home, irrigation, municipal, industrial)

WELL COMPLETION DATA:

- (1) diameter (inches) 4
- (2) total depth (feet) 155
- (3) static water level (feet) 50 below top of ground.
- (4) casing Alum. (material) 147 (depth)  
(size) if telescope see back.
- (5) screen 8 (length) 147 (depth to top)  
(size) Alum. (material)
- (6) pump 1/2 (HP) 10 (yield gpm)  
elec (type power)
- (7) electric log no (yes or no)  
(organization running log)
- (8) how well bottom plugged Good

**CODED**


APR 10 1971

MISS. BD. OF WATER COMMISSIONERS

DRILLERS REMARKS:

If well telescopes please sketch and show depths.

GROUND LEVEL

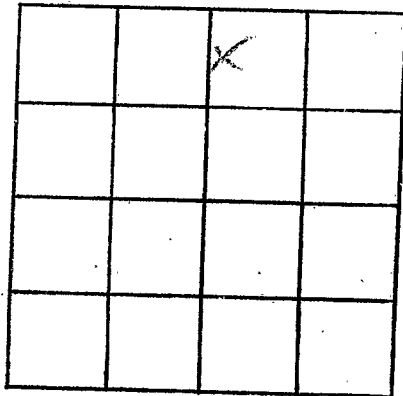

SECTION 1

Please indicate well location X.

ADDITIONAL INFORMATION

If more than one screen,  
show locations of each on sketch.