

WALTHALL
D-35
8-30-71

MISSISSIPPI
BOARD OF WATER COMMISSIONERS
416 North State Street
Jackson, Mississippi 39201

CODED

WATER WELL DRILLERS LOG

8-30-1971 date well completed
Griner Drilling Service firm name
Walthall county well located

LANDOWNER: No. A-1
McDonnal Trust
Fortenbury Drilling Co.
(mailing address)

description of formations encountered	from	to
	Top Soil	0
Sand and Gravel	3	273

WELL LOCATION:
sec 34 T 3 N R 11 E
1000'S + 1000' W OF NE/EN.
miles of (nearest town)

WELL PURPOSE: Oil Field
(home, irrigation, municipal, industrial)

- WELL COMPLETION DATA:
- (1) diameter (inches) 3
 - (2) total depth (feet) 273
 - (3) static water level (feet) 80 below top of ground.
 - (4) casing B.I. 252' (material) (depth)
3" (size) if telescope see back.
 - (5) screen 21 252 (length) (depth to top)
3 B.I.-Slotted (size) (material)
 - (6) pump N/A 65 (HP) (yield gpm)
Air Compressor (type power)
 - (7) electric log NO (yes or no)
NO (organization running log)
 - (8) how well bottom plugged welded closed, Orange Pool


SEP 2 1971

MISS. BD. OF WATER COMM.

DRILLERS REMARKS:

If well telescopes please sketch and show depths.

GROUND LEVEL

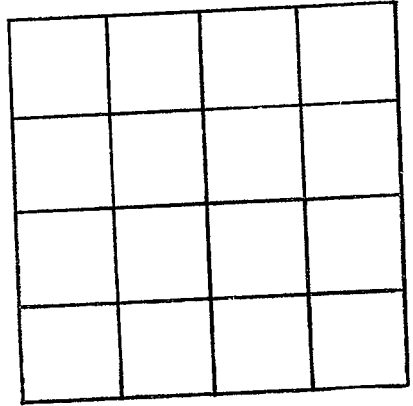

SECTION _____

Please indicate well location X.

ADDITIONAL INFORMATION

If more than one screen, show locations of each on sketch.