

WALTHALL

D 37

9-14-71

MISSISSIPPI BOARD OF WATER COMMISSIONERS
416 North State Street
Jackson, Mississippi 39201

SEP 23 1971

WATER WELL DRILLERS LOG

CODED

Sept 14 1971 date well completed
Chester Reuland firm name
Walthall county well located

LANDOWNER: Walthall Stewart
RF-1, Tylertown -
(mailing address)

description of formations encountered
clay
Red chalky sand
from 0 to 8 72

WELL LOCATION:
sec. 15 T 3 N R. 11 E
7 1/2 miles NW 1/2 of Tylertown
(distance) (direction) (nearest town)

Small gravel
72-90

WELL PURPOSE: drain
(home, irrigation, municipal, industrial)

WELL COMPLETION DATA:

- (1) diameter (inches) 4"
- (2) total depth (feet) 90
- (3) static water level (feet) 21 below top of ground.
- (4) casing Plast Bottom
(material) (depth)

(size) if telescope see back.

- (5) screen 6' 4 1/2'
(length) (depth to top)
- 4" Plast
(size) (material)

- (6) pump 1/2 Sub 1/2
(HP) (yield gpm)
- Telect
(type power)

- (7) electric log no
(yes or no)

(organization running log)


- (8) how well bottom plugged wonderful

DRILLERS REMARKS:

CODED

If well telescopes please sketch and show depths.

GROUND LEVEL

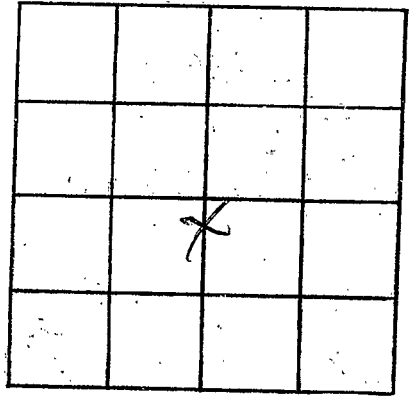

SECTION 15

Please indicate well location X.

ADDITIONAL INFORMATION

If more than one screen, show locations of each on sketch.