

WALTHALL
D 39
2-5-72

MISSISSIPPI
BOARD OF WATER COMMISSIONERS
416 North State Street
Jackson, Mississippi 39201

WATER WELL DRILLERS LOG

CODED

2-5
date well completed

1972 *Fitzgibbon*
firm name

Walthall
county well located

LANDOWNER:	description of formations encountered	from	to
<i>H. R. Bracy</i>			
<i>R. R. Golden</i> (mailing address)	<i>Red clay concrete sand</i>	<i>0 20</i>	<i>20 130</i>
WELL LOCATION:			
sec <i>3</i> T. <i>3</i> N. R. <i>11</i> E			
<i>8</i> miles (distance) <i>NW 1/4</i> (direction) of <i>Walthall</i> (nearest town)			
WELL PURPOSE: <i>Home</i> (home, irrigation, municipal, industrial)			
WELL COMPLETION DATA:			
(1) diameter (inches) <i>4</i>			
(2) total depth (feet) <i>130</i>			
(3) static water level (feet) <i>70</i> below top of ground.			
(4) casing <i>Plastic 122</i> (material) (depth)			
<i>4</i> (size) if telescope see back.			
(5) screen <i>8</i> (length), <i>122</i> (depth to top)			
<i>4</i> (size), <i>Plastic</i> (material)			
(6) pump <i>3/4</i> (HP), <i>15</i> (yield gpm)			
<i>Walt</i> (type power)			
(7) electric log <i>no</i> (yes or no)			
(organization running log)			
(8) how well bottom plugged <i>loose</i>			
DRILLERS REMARKS:			


CODED

JUN 19 1972

MISS. DIV. OF
WATER CONTROL

If well telescopes please sketch and show depths.

GROUND LEVEL

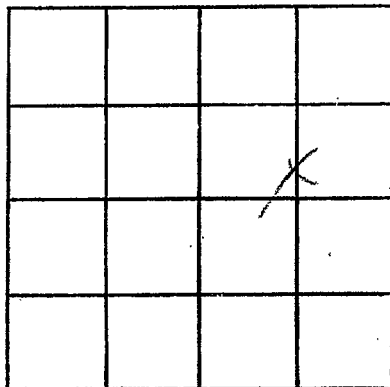

SECTION 3

Please indicate well location X.

ADDITIONAL INFORMATION

If more than one screen,
show locations of each on sketch.