

WALTHALL
D 40
4-72

MISSISSIPPI
 BOARD OF WATER COMMISSIONERS
 416 North State Street
 Jackson, Mississippi 39201

CODED

WATER WELL DRILLERS LOG

April 1972 E. B. Sheppard Walthall
 date well completed firm name county well located

LANDOWNER:
 Alice Magee
 Ipreteron, Miss.
 (mailing address)

description of formations encountered	from	to
RED CLAY	0	70'
SANDY BEDS		
GRAVEL BEDS WITH CLAY STRAKS	70	140'
SMALL PEAS & COARSE SAND	140	160'

WELL LOCATION:
 sec 36 T 3 N R 12 E
 S 11 W
 7 miles NE Ipreteron
 (distance) (direction) (nearest town)

WELL PURPOSE:
 (home, irrigation, municipal, industrial)

- WELL COMPLETION DATA:**
- (1) diameter (inches) 2"
 - (2) total depth (feet) 160'
 - (3) static water level (feet) 8 ^{below} above top of ground.
 - (4) casing pl. 155'
 (material) (depth)
2" if telescope see back.
 (size)
 - (5) screen 5' pl.
 (length) (depth to top)
2" (size) (material)
 - (6) pump 1 1/2 7
 (HP) (yield gpm)
E
 (type power)
 - (7) electric log (yes or no)
 (organization running log)
 - (8) how well bottom plugged BWU

CODED


MAY 26 1972

MISS. on Ur
 WATER COMM.

DRILLERS REMARKS:

If well telescopes please sketch and show depths.

GROUND LEVEL

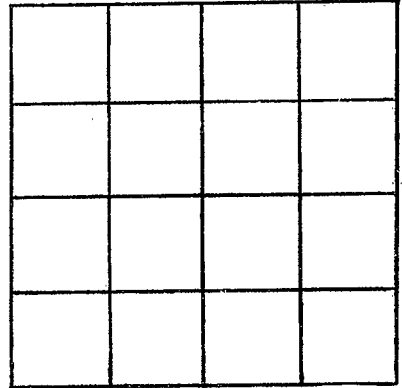

SECTION _____

Please indicate well location X.

ADDITIONAL INFORMATION

If more than one screen, show locations of each on sketch.