

WALTHALL
D 42
8-15-72

MISSISSIPPI
 BOARD OF WATER COMMISSIONERS
 416 North State Street
 Jackson, Mississippi 39201

CODED

WATER WELL DRILLERS LOG

Aug 15 1972 Fitzgibbon Walthall
 date well completed firm name county well located


| LANDOWNER: | description of formations encountered | from | to |
|--|--|------------------------------------|--------------------------------------|
| <u>Dr. P. Walker</u> | | | |
| <u>RR Light, Miss</u> (mailing address) | <u>Red clay</u> <u>white clay</u> <u>Carroll Limestone</u> | <u>0</u> <u>20</u> <u>90</u> | <u>20</u> <u>90</u> <u>117</u> |
| WELL LOCATION: | | | |
| sec. <u>25</u> T. <u>3</u> N. R. <u>11</u> E | | | |
| <u>5</u> miles <u>E</u> of <u>Light</u> (distance) (direction) (nearest town) | | | |
| WELL PURPOSE: <u>Home</u> (home, irrigation, municipal, industrial) | | | |
| WELL COMPLETION DATA: | | | |
| (1) diameter (inches) <u>4</u> | | | |
| (2) total depth (feet) <u>117</u> | | | |
| (3) static water level (feet) <u>70</u> below above top of ground. | | | |
| (4) casing <u>plaster</u> <u>109</u> (material) (depth) | | | |
| <u>4</u> if telescope see back. (size) | | | |
| (5) screen <u>8</u> <u>109</u> (length) (depth to top) | | | |
| <u>4</u> <u>plaster</u> (size) (material) | | | |
| (6) pump <u>1/2</u> <u>10</u> (HP) (yield gpm) | | | |
| <u>oil</u> (type power) | | | |
| (7) electric log <u>no</u> (yes or no) | | | |
| (organization running log) | | | |
| (8) how well bottom plugged <u>about 1/2</u> | | | |
| DRILLERS REMARKS: | | | |

CODED

MISS. BD. OF
 WATER COMMISSIONERS

If well telescopes please sketch and show depths.

GROUND LEVEL

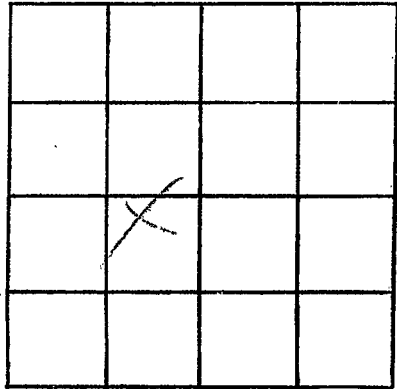

SECTION 35

Please indicate well location X.

ADDITIONAL INFORMATION

If more than one screen, show locations of each on sketch.