

WALTHALL
D43
9-12-72

MISSISSIPPI
BOARD OF WATER COMMISSIONERS
416 North State Street
Jackson, Mississippi 39201

CODED

WATER WELL DRILLERS LOG

9-12 1972 Equall Well Serv Walthall
date well completed firm name county well located

LANDOWNER:

Jerry Brumfield
R.R. Lyntown, Miss.
(mailing address)

description of formations encountered

from to

Red clay	0	20
Red sand	20	60
Red gravel	60	80
White clay	80	130
Fine sand	130	150
Coarse sand & gravel	150	161

WELL LOCATION:

sec. 16 T 3 N R 11 E
1/2 miles E of Salem
(distance) (direction) (nearest town)

WELL PURPOSE:

(home, irrigation, municipal, industrial) Home

WELL COMPLETION DATA:

- (1) diameter (inches) 4
- (2) total depth (feet) 161
- (3) static water level (feet) 80 below above top of ground.
- (4) casing Plastic, 153,
(material) (depth)
4 if telescope see back.
(size)
- (5) screen 8, 153
(length) (depth to top)
4, Plastic
(size) (material)
- (6) pump 1, 5
(HP) (yield gpm)
Electric
(type power)
- (7) electric log No
(yes or no)
- (organization running log)

CODED

(8) how well bottom plugged Wood plug


OCT 17 1972

DRILLERS REMARKS:

MISS. BD. OF
WATER COMMISSIONERS

If well telescopes please sketch and show depths.

GROUND LEVEL

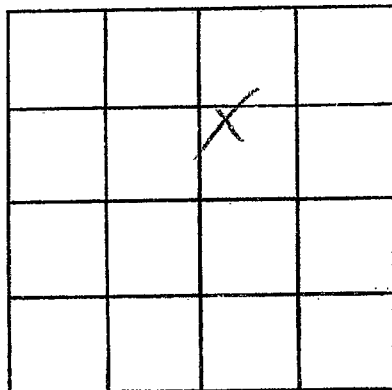

SECTION 76

Please indicate well location X.

ADDITIONAL INFORMATION

If more than one screen, show locations of each on sketch.