

WALTHALL  
D45  
10-9-72

MISSISSIPPI  
BOARD OF WATER COMMISSIONERS  
416 North State Street  
Jackson, Mississippi 39201

**CODED**

WATER WELL DRILLERS LOG

Oct 9 1972 date well completed  
Chester Keener Walthall firm name  
Walthall county well located

LANDOWNER: Johnnie L. Davis  
Rt 1, Tylertown  
(mailing address)

description of formations encountered	from	to
Red clay	0	17
Mixed sand & gravel	17	62
Gravelly sand	62	90
Sand & gravel	90	104

WELL LOCATION:  
sec. 9 T. 3 N. R. 4 E  
9 miles NNE of Tylertown  
(distance) (direction) (nearest town)

WELL PURPOSE: Drain  
(home, irrigation, municipal, industrial)

WELL COMPLETION DATA:

- (1) diameter (inches) 6"
- (2) total depth (feet) 104
- (3) static water level (feet) 79 below above top of ground.
- (4) casing Plast. hollow  
(material) (depth)  
         If telescope see back.  
(size)
- (5) screen 6' 98  
(length) (depth to top)  
1/2" Plast  
(size) (material)
- (6) pump Bygoner  
(HP) (yield gpm)  
          
(type power)
- (7) electric log no  
(yes or no)  
          
(organization running log)

**CODED**


(8) how well bottom plugged: wood plug

DRILLERS REMARKS:

MISSISSIPPI  
BOARD OF WATER COMMISSIONERS  
WATER CODE

If well telescopes please  
sketch and show depths.

GROUND LEVEL

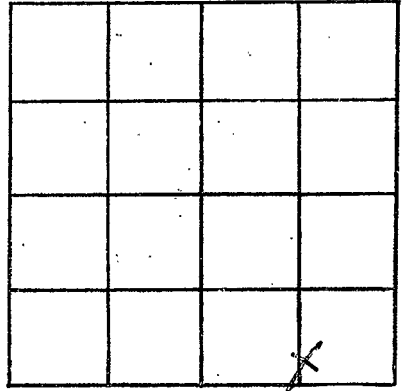

SECTION 9

Please indicate well location X.

ADDITIONAL INFORMATION

If more than one screen,  
show locations of each on sketch.