

CODED

D47
WALTHALL
8-9-73

MISSISSIPPI
BOARD OF WATER COMMISSIONERS
416 North State Street
Jackson, Mississippi 39201

WATER WELL DRILLERS LOG

8-9 1973 Fitzgerald Walthall
date well completed firm name county well located

LANDOWNER:
Rob McKenzie
R.R. Galt
(mailing address)

description of formations encountered	from	to
<u>Red Clay</u>	<u>0</u>	<u>20</u>
<u>Red Sand</u>	<u>20</u>	<u>90</u>
<u>Coarse Sand & gravel</u>	<u>90</u>	<u>124</u>

WELL LOCATION:
sec. 16 T. 3 N. R. 11 E
2 miles E of Salmon
(distance) (direction) (nearest town)

WELL PURPOSE:
Home
(home, irrigation, municipal, industrial)

WELL COMPLETION DATA:
(1) diameter (inches) 4
(2) total depth (feet) 124
(3) static water level (feet) 90 below above top of ground.
(4) casing plastic 116
(material) (depth)
1 if telescope see back.
(size)
(5) screen 8 116
(length) (depth to top)
4 plastic
(size) (material)
(6) pump 1/2 10
(HP) (yield gpm)
Electric
(type power)
(7) electric log no
(yes or no)
(organization running log)


(8) how well bottom plugged wealy

AUG 15 1973

DRILLERS REMARKS:

If well telescopes please
sketch and show depths.

GROUND LEVEL

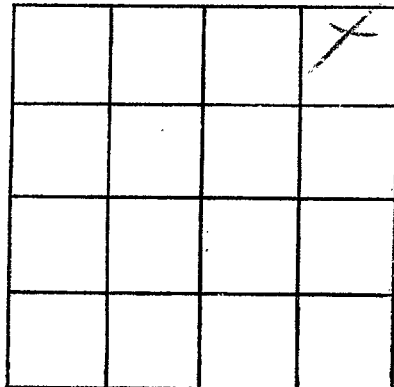

SECTION 16

Please indicate well location X.

ADDITIONAL INFORMATION

Lined area for additional information.

If more than one screen,
show locations of each on sketch.