

D 49
 WALTHALL
 7-24-73

MISSISSIPPI
 BOARD OF WATER COMMISSIONERS
 416 North State Street
 Jackson, Mississippi 39201

CODED


WATER WELL DRILLERS LOG

7-24 1973 Hessell Well Serv Walthall
 date well completed firm name county well located

LANDOWNER:	description of formations encountered	from	to
<u>Scott Fern</u> <u>P.R. Glute</u> (mailing address)			
WELL LOCATION: sec. <u>19</u> T. <u>3</u> (N) S R. <u>11</u> (E) W <u>1</u> miles <u>W</u> of <u>Sabon</u> (distance) (direction) (nearest town)			
WELL PURPOSE: <u>Home</u> (home, irrigation, municipal, industrial)			
WELL COMPLETION DATA: (1) diameter (inches) <u>4</u> (2) total depth (feet) <u>130</u> (3) static water level (feet) <u>25</u> below above top of ground. (4) casing <u>plastic</u> <u>122</u> (material) (depth) <u>4</u> if telescope see back. (size) (5) screen <u>8</u> <u>122</u> (length) (depth to top) <u>4</u> <u>plastic</u> (size) (material) (6) pump <u>1/2</u> <u>10</u> (HP) (yield gpm) <u>elc</u> (type power) (7) electric log <u>no</u> (yes or no) (organization running log) (8) how well bottom plugged <u>wood plug</u>			
DRILLERS REMARKS:			

If well telescopes please sketch and show depths.

GROUND LEVEL

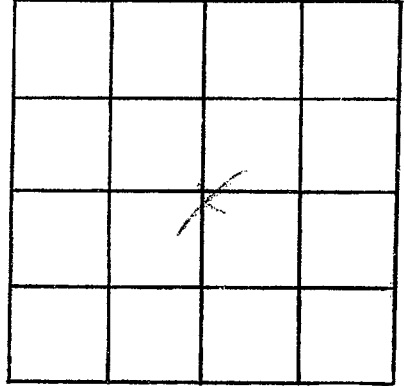

SECTION 19

Please indicate well location X.

ADDITIONAL INFORMATION

If more than one screen,
show locations of each on sketch.