

D 50  
 WALTHALL  
 6-30-73

MISSISSIPPI  
 BOARD OF WATER COMMISSIONERS  
 416 North State Street  
 Jackson, Mississippi 39201

**CODE**

WATER WELL DRILLERS LOG

June 30, 1973 Chester Keener Walthall  
 date well completed firm name county well located

LANDOWNER: Harris Kupper  
Tylerbauer's  
 (mailing address)

WELL LOCATION:  
 sec. 8 T. 3 N. R. 1 E  
9 miles NNE of Tylerbauer  
 (distance) (direction) (nearest town)

WELL PURPOSE: Home  
 (home, irrigation, municipal, industrial)

- WELL COMPLETION DATA:
- (1) diameter (inches) 4"
  - (2) total depth (feet) 100
  - (3) static water level (feet) 14 below above top of ground.
  - (4) casing Plast, Buttress  
 (material) (depth)
  - \_\_\_\_\_ If telescope see back.  
 (size)
  - (5) screen 6', 94'  
 (length) (depth to top)
  - 4", Plast  
 (size) (material)
  - (6) pump Byaumer  
 (HP) (yield gpm)
  - \_\_\_\_\_ (type power)
  - (7) electric log NO  
 (yes or no)
  - \_\_\_\_\_ (organization running log)
  - (8) how well bottom plugged wooden plug

description of formations encountered	from	to
clay	0	17
fine sand	17	25
Coarse sand	25	30
Loose sand	30	37
Coarse sand	37	100


**VOIDED**

DRILLERS REMARKS:  
old well back

AUG 20 1973

If well telescopes please sketch and show depths.

GROUND LEVEL

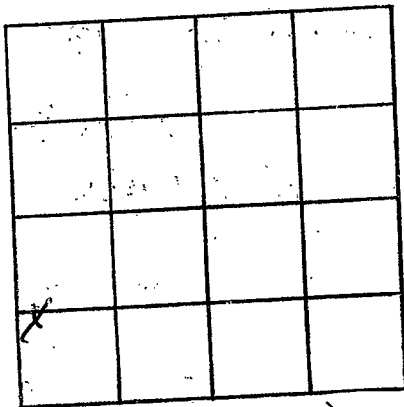

SECTION 8

Please indicate well location X.

ADDITIONAL INFORMATION

If more than one screen, show locations of each on sketch.