

**WALTHALL**  
**D51**  
**4-4-74**

MISSISSIPPI  
 BOARD OF WATER COMMISSIONERS  
 416 North State Street  
 Jackson, Mississippi 39201

**CODED**

**WATER WELL DRILLERS LOG**

4 April 1974 J-T. Carngate, Inc Walthall  
 date well completed firm name county well located

LANDOWNER:  
Flora James  
Tylertown Miss.  
 (mailing address)

description of formations encountered	from	to
<u>clay</u>	<u>0</u>	<u>20</u>
<u>soft chert</u>	<u>20</u>	<u>45</u>
<u>clay</u>	<u>45</u>	<u>55</u>
<u>sand</u>	<u>55</u>	<u>94</u>

WELL LOCATION:  
 sec. 18 T. 3 N. R. 11 E.  
2 miles W of Salem  
 (distance) (direction) (nearest town)

WELL PURPOSE:  
 (home, irrigation, municipal, industrial)

WELL COMPLETION DATA:

(1) diameter (inches) 4

(2) total depth (feet) 94

(3) static water level (feet) 70 below above top of ground.

(4) casing pl 88  
 (material) (depth)

         If telescope see back.  
 (size)

(5) screen 6 88  
 (length) (depth to top)

4 pl  
 (size) (material)

(6) pump 1/2 8  
 (HP) (yield gpm)

Elect  
 (type power)

(7) electric log           
 (yes or no)

          
 (organization running log)

(8) how well bottom plugged Wood


**CODED**

DRILLERS REMARKS:  
        

MAY 1 10 1974  
 MISS. RD. DEPT. OF WATER CONTROL

If well telescopes please sketch and show depths.

GROUND LEVEL

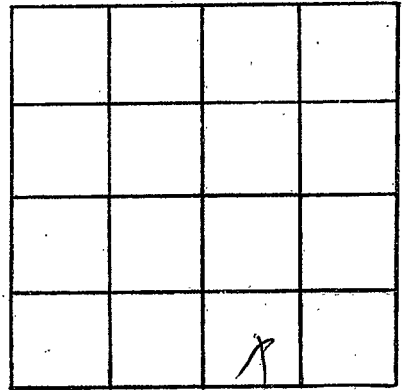

SECTION 18

Please indicate well location X.

ADDITIONAL INFORMATION

If more than one screen, show locations of each on sketch.