

WALTHALL  
D52  
10/73

MISSISSIPPI  
BOARD OF WATER COMMISSIONERS  
416 North State Street JACKSON, Mississippi 39201

WATER WELL DRILLERS LOG

Oct. 23 1973 E. B. Sherrard Walthall  
date well completed firm name county well located

LANDOWNER:  
Mr. Glen Harney  
Rt. 5 - Joplin, Miss.  
(mailing address)

description of formations encountered	from	to
SANDY CLAY	0	15'
FINE SAND	15'	40'
DEA GR.	40	50


WELL LOCATION:  
sec. 32 T. 3 N. R. 11 E  
3 miles N of Joplin  
(distance) (direction) (nearest town)

WELL PURPOSE:  
(home, irrigation, municipal, industrial)

- WELL COMPLETION DATA:
- (1) diameter (inches) 2"
  - (2) total depth (feet) 50'
  - (3) static water level (feet) 20' <sup>below</sup> above top of ground.
  - (4) casing pl. 45'  
(material) (depth)  
2" if telescope see back.  
(size)
  - (5) screen 5' pl.  
(length) (depth to top)  
2" (size) (material)
  - (6) pump 1 8  
(HP) (yield gpm)  
E.  
(type power)
  - (7) electric log (yes or no) (no)  
(organization running log)
  - (8) how well bottom plugged BLW

CODED


DRILLERS REMARKS:

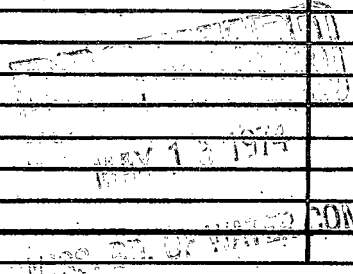

DOWN

If well telescopes please sketch and show depths.

GROUND LEVEL

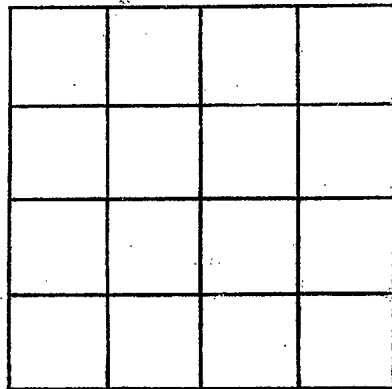

SECTION \_\_\_\_\_

Please indicate well location X.

ADDITIONAL INFORMATION

If more than one screen, show locations of each on sketch.