

WALTHALL
D53
3/74

MISSISSIPPI
BOARD OF WATER COMMISSIONERS
416 North State Street
Jackson, Mississippi 39201

CODED

WATER WELL DRILLERS LOG

March 1974 E. B. Sherrard Walthall
date well completed firm name county well located

LANDOWNER:

Monroe Griffin
Rt. 1 Zylertown, Miss.
(mailing address)

description of formations encountered

SAND + GRAVEL 0 65'

from

to

WELL LOCATION:

sec 17 T 3 N R 11 E
S W
7 miles N Zylertown
(distance) (direction) (nearest town)

WELL PURPOSE:

(home, irrigation, municipal, industrial)

CODED

WELL COMPLETION DATA:

- (1) diameter (inches) 2"
- (2) total depth (feet) 65'
- (3) static water level (feet) 22' ^{below} _{above} top of ground.
- (4) casing pl. 60' (material) (depth)
2" (size) if telescope see back.
- (5) screen 5' (length) (depth to top)
2" (size) pl. (material)
- (6) pump 1 (HP) 7 (yield gpm)
E (type power)
- (7) electric log (yes or no) (no)

(organization running log)

(8) how well bottom plugged BWV

RECEIVED


JUL - 1 1974

DRILLERS REMARKS:

MISS. BD. OF WATER COMMISSIONERS

If well telescopes please sketch and show depths.

GROUND LEVEL

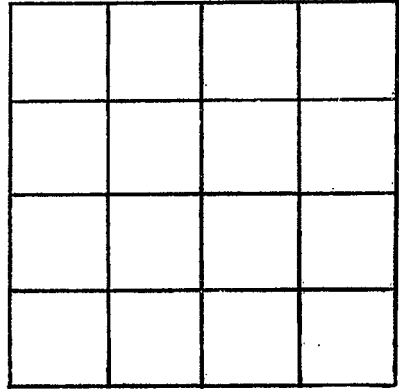

SECTION _____

Please indicate well location X.

ADDITIONAL INFORMATION

If more than one screen,
show locations of each on sketch.