

WALTHALL
D54
9/13/78

MISSISSIPPI
BOARD OF WATER COMMISSIONERS
416 North State Street
Jackson, Mississippi 39201

CODED

WATER WELL DRILLERS LOG

9-13
date well completed

19 74
firm name

Fitzgould well service

Walthall
county well located

LANDOWNER:

Salem Baptist Church (Parsonage)

R.B. Fitzgould
(mailing address)

description of formations encountered

from to

Red clay	0	20
white chert	20	135
Coarse sand	135	150

WELL LOCATION:

sec. 17 T. 3 N. R. 11 E.
S W

6 miles N of Fitzgould
(distance) (direction) (nearest town)

WELL PURPOSE: Home
(home, irrigation, municipal, industrial)

WELL COMPLETION DATA:

- (1) diameter (inches) 4
- (2) total depth (feet) 150
- (3) static water level (feet) 40 below above top of ground.
- (4) casing (material) plastic, (depth) 142
4 (size) if telescope see back.
- (5) screen (length) 8, (depth to top) 142
4 (size), plastic (material)
- (6) pump (HP) 1, (yield gpm) 8
electric (type power)
- (7) electric log (yes or no) no
- (organization running log)
- (8) how well bottom plugged sand chert


CODED

DRILLERS REMARKS:

001
MISSISSIPPI
BOARD OF WATER COMMISSIONERS

If well telescopes please sketch and show depths.

GROUND LEVEL

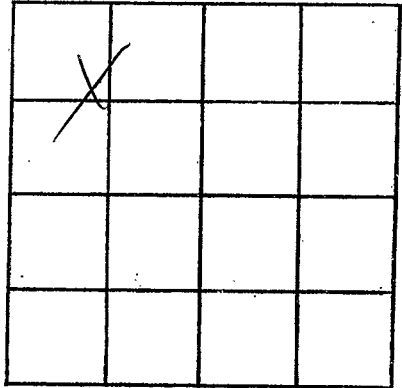

SECTION 17

Please indicate well location X.

ADDITIONAL INFORMATION

If more than one screen,
show locations of each on sketch.