

WALTHALL
D 56
11-18-74

MISSISSIPPI
 BOARD OF WATER COMMISSIONERS
 416 North State Street
 Jackson, Mississippi 39201

CODED

WATER WELL DRILLERS LOG

11-18 date well completed 1974 *Fitzgerald Well Service* firm name *Walthall* county well located

LANDOWNER:	description of formations encountered	from	to
<i>Ermitt Landlifes</i>			
<i>R.R. Telectraun</i> (mailing address)	<i>Red clay</i>	<i>0</i>	<i>20</i>
WELL LOCATION:	<i>Red gravel</i>	<i>20</i>	<i>60</i>
sec. <i>29</i> T- <i>3</i> N <i>S</i> R- <i>11</i> E <i>E</i> <i>5</i> miles <i>N</i> of <i>Telectraun</i> (distance) (direction) (nearest town)	<i>White chalk</i>	<i>60</i>	<i>170</i>
WELL PURPOSE: <i>Home</i> (home, irrigation, municipal, industrial)	<i>Coarse sand -</i>	<i>170</i>	<i>192</i>
WELL COMPLETION DATA:			
(1) diameter (inches) <i>4"</i>			
(2) total depth (feet) <i>192</i>			
(3) static water level (feet) <i>75'</i> below top of ground.			
(4) casing <i>plastic</i> , <i>184</i> , (material) (depth)			
<i>4</i> If telescope see back. (size)			
(5) screen <i>8</i> , <i>184</i> (length) (depth to top)			
<i>4</i> , <i>plastic</i> (size) (material)			
(6) pump <i>1/2</i> , <i>10</i> (HP) (yield gpm)			
<i>elec</i> (type power)			
(7) electric log <i>No</i> (yes or no)			
(organization running log)			
(8) how well bottom plugged <i>Landbank</i>			
DRILLERS REMARKS:			


CODED

RECEIVED
 FEB 10 1975

MISS. RD. OF WATER COMMISSIONERS

If well telescopes please sketch and show depths.

GROUND LEVEL

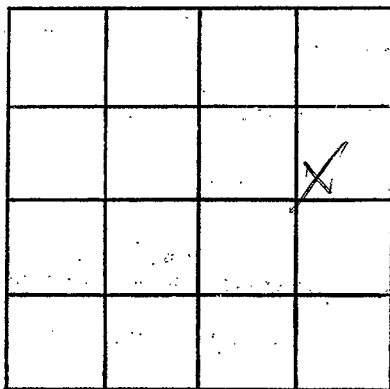

SECTION 29

Please indicate well location X.

ADDITIONAL INFORMATION

If more than one screen, show locations of each on sketch.