

WALTHALL  
 DS7  
 2-5-74

MISSISSIPPI  
 BOARD OF WATER COMMISSIONERS  
 416 North State Street  
 Jackson, Mississippi 39201

CODED

WATER WELL DRILLERS LOG

Feb 15 1974 Chester Leves Walthall  
 date well completed firm name county well located

LANDOWNER: Beechie Hart

Rt 1, Tylertown

description of formations encountered

from to

|                     |    |    |
|---------------------|----|----|
| Red clay & gravel   | 0  | 12 |
| fine sand           | 12 | 23 |
| clay                | 23 | 25 |
| small gravel & sand | 25 | 42 |

(mailing address)

WELL LOCATION:

sec. 32 T. 3 N R. 14 E 130  
 5 miles north of Tylertown  
 (distance) (direction) (nearest town)

WELL PURPOSE: Home  
 (home, irrigation, municipal, industrial)

WELL COMPLETION DATA:


- (1) diameter (inches) 4"
- (2) total depth (feet) 42
- (3) static water level (feet) 9 below top of ground
- (4) casing Plast Ballast  
 (material) (depth)
- (size) If telescope see back.
- (5) screen 6' 36'  
 (length) (depth to top)
- (size) 4" Plast  
 (material)
- (6) pump brushless  
 (HP) (yield gpm)
- (type power) 200'
- (7) electric log no  
 (yes or no)

(organization running log)

(8) how well bottom plugged  
wooden plug

DRILLERS REMARKS:


CODED

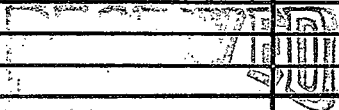

FEB 12 1974

If well telescopes please sketch and show depths.

GROUND LEVEL

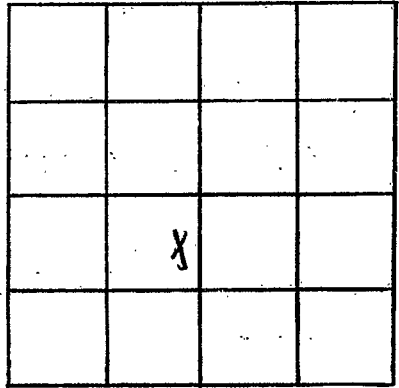

SECTION 32

Please indicate well location X.

ADDITIONAL INFORMATION

If more than one screen, show locations of each on sketch.