

near Sexton Store

WALTHALL  
D58  
3-4-74

MISSISSIPPI  
BOARD OF WATER COMMISSIONERS  
416 North State Street  
Jackson, Mississippi 39201

CODED

WATER WELL DRILLERS LOG

March 4 1974 Chester Keenes Walthall  
date well completed firm name county well located

LANDOWNER: Garace Smith  
Rt-1, Tylertown

description of formations encountered

from to

Red clay	0	22
Red sand gravel	22	81
Small gravel sand	81	94

(mailing address)

WELL LOCATION:

sec. 20 T 3 N R 11 E 130  
1/2 miles north of Tylertown

(distance) (direction) (nearest town)

WELL PURPOSE: Home  
(home, irrigation, municipal, industrial)

CODED

WELL COMPLETION DATA:

- (1) diameter (inches) 4"
- (2) total depth (feet) 94
- (3) static water level (feet) 116 below top of ground
- (4) casing Plast bottom  
(material) (depth)
- (5) screen 6' 88'  
(length) (depth to top)  
4" Plast  
(size) (material)
- (6) pump 1/2 sub 15  
(HP) (yield gpm)  
Elect  
(type power)
- (7) electric log NO  
(yes or no)

(organization running log)

(8) how well bottom plugged woodchip


DRILLERS REMARKS:

New house

RECEIVED  
FEB 12 1975  
MISS. BD. OF WATER COMMISSIONERS

If well telescopes please sketch and show depths.

GROUND LEVEL

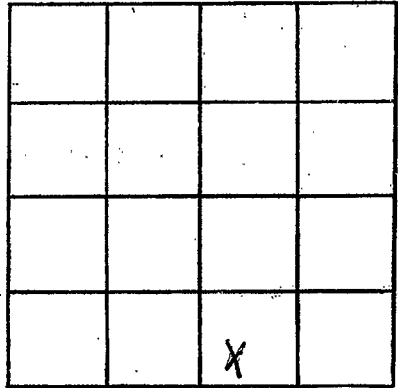

SECTION 20

Please indicate well location X.

ADDITIONAL INFORMATION

If more than one screen, show locations of each on sketch.