

WALTHALL  
 D59  
 3-19-75

MISSISSIPPI  
 BOARD OF WATER COMMISSIONERS  
 416 North State Street  
 Jackson, Mississippi 39201

CODED

WATER WELL DRILLERS LOG

3-19-75 date well completed      Fitzgerald firm name      Walthall county well located

LANDOWNER:	description of formations encountered	from	to
<u>Clude Andrews</u>			
<u>R.R. Kolomo -</u> (mailing address)	<u>Red clay</u>	<u>0</u>	<u>20</u>
	<u>Red sand</u>	<u>20</u>	<u>175</u>
	<u>Coarse sand &amp; gravel</u>	<u>175</u>	<u>188</u>

WELL LOCATION:  
 sec. 36 T. 3 N. R. 11 E  
4 miles W of Kolomo  
 (distance) (direction) (nearest town)

WELL PURPOSE: Home  
 (home, irrigation, municipal, industrial)

- WELL COMPLETION DATA:
- diameter (inches) 4
  - total depth (feet) 188
  - static water level (feet) 98 below top of ground.
  - casing plastic, 180,  
(material) (depth)  
4 If telescope see back.  
(size)
  - screen 8, 180  
(length) (depth to top)  
4, plastic  
(size) (material)
  - pump 1/2, 10  
(HP) (yield gpm)  
elec  
(type power)
  - electric log yes  
(yes or no)  
(organization running log)
  - how well bottom plugged Sand block


CODED

RECEIVED  
 APR - 2 1975

DRILLERS REMARKS:

If well telescopes please sketch and show depths.

GROUND LEVEL

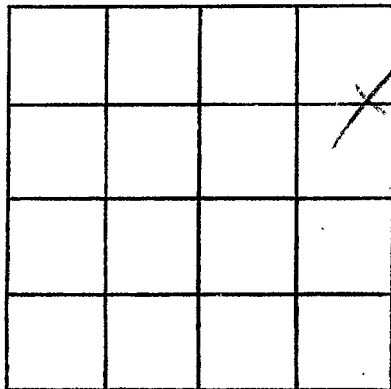

SECTION 34

Please indicate well location X.

ADDITIONAL INFORMATION

If more than one screen,  
show locations of each on sketch.