

**WALTHALL**  
**D60**  
**1-22-75**

MISSISSIPPI  
 BOARD OF WATER COMMISSIONERS  
 416 North State Street  
 Jackson, Mississippi 39201

**WATER WELL DRILLERS LOG**

**CODED**

27 Jan 1975 J.T. Compton Walthall  
 date well completed firm name county well located

**LANDOWNER:**  
 Cloud Holmes  
 Fayetteville  
 (mailing address)

description of formations encountered	from	to
Clay	0	20
Chalk	20	45
Sand, clay	45	65
Sand	65	122

**WELL LOCATION:**  
 sec. 27 T 1 N R 11 E  
 S W  
 8 miles N of Fayetteville  
 (distance) (direction) (nearest town)

**WELL PURPOSE:**  
 (home, irrigation, municipal, industrial)

- WELL COMPLETION DATA:**
- (1) diameter (inches) 4
  - (2) total depth (feet) 122
  - (3) static water level (feet) 85 below above top of ground.
  - (4) casing (material) PL (depth) 116 (size) if telescope see back.
  - (5) screen (length) 6 (depth to top) 116 (size) 4 (material) PL
  - (6) pump (HP) 1/2 (yield gpm) 8 (type power) elec
  - (7) electric log (yes or no)
  - (8) how well bottom plugged good

**CODED**


**DRILLERS REMARKS:**

RECEIVED  
 JAN 27 1975

ADD - 7 1975

If well telescopes please sketch and show depths.

GROUND LEVEL

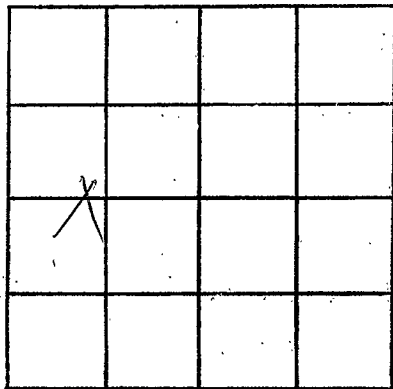

SECTION: 25

Please indicate well location X.

ADDITIONAL INFORMATION

If more than one screen, show locations of each on sketch.