

Walthall  
D 61  
5-27-75

MISSISSIPPI  
BOARD OF WATER COMMISSIONERS  
416 North State Street  
Jackson, Mississippi 39201

CODED


WATER WELL DRILLERS LOG

May 27 1975 Reems Well Drilling Walthall  
date well completed firm name county well located

LANDOWNER:	description of formations encountered	from	to
<u>Amos Newman</u> <u>Rt Fayetteville</u> (mailing address)			
WELL LOCATION: sec <u>37</u> T <u>3</u> N R <u>11</u> E <u>5</u> miles <u>south</u> of <u>Fayetteville</u> (distance) (direction) (nearest town)	<u>Red Clay</u> <u>Red sand</u> <u>Brown gravel</u> <u>Blue Chalk</u> <u>fine white sand</u> <u>sands pea gravel</u>	<u>0</u> <u>16</u> <u>32</u> <u>55</u> <u>120</u> <u>168</u>	<u>16</u> <u>32</u> <u>55</u> <u>120</u> <u>168</u> <u>190</u>
WELL PURPOSE: <u>house</u> (home, irrigation, municipal, industrial)			
WELL COMPLETION DATA: (1) diameter (inches) <u>4"</u> (2) total depth (feet) <u>180</u> (3) static water level (feet) <u>45</u> below top of ground. (4) casing <u>plastic bottom</u> (material) (depth) <u>6"</u> If telescope see back. (size) (5) screen <u>6"</u> <u>174</u> (length) (depth to top) <u>6"</u> <u>plastic</u> (size) (material) (6) pump <u>1/2</u> <u>6</u> (HP) (yield gpm) <u>elect</u> (type power) (7) electric log <u>NO</u> (yes or no) (organization running log) (8) how well bottom plugged <u>wooden plug</u>			
DRILLERS REMARKS: <u>new house site</u>			

If well telescopes please sketch and show depths.

GROUND LEVEL

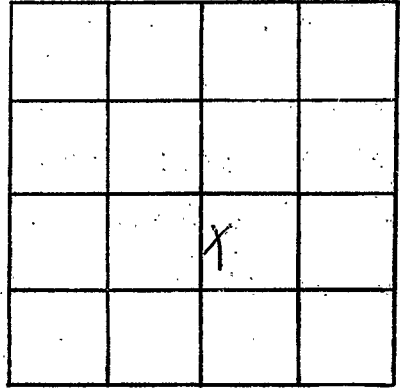

SECTION 32

Please indicate well location X.

ADDITIONAL INFORMATION

If more than one screen, show locations of each on sketch.