

Wathall
D 62
10-9-75

MISSISSIPPI
BOARD OF WATER COMMISSIONERS
416 North State Street
Jackson, Mississippi 39201

WATER WELL DRILLERS LOG

CODED

10-9 1975 *Int'l Groundwater Serv* *Wathall*
date well completed firm name county well located

LANDOWNER:
Ewart Lanlife
R.B. Lytle
(mailing address)

description of formations encountered	from	to
<i>Red clay</i>	0	20
<i>Red sand</i>	20	60
<i>white clay</i>	60	140
<i>Coarse sand & gravel</i>	140	152

WELL LOCATION:
sec. 29T 36(N) R. 11(E)
6 miles N of Lytle
(distance) (direction) (nearest town)

WELL PURPOSE: Home
(home, irrigation, municipal, industrial)

- WELL COMPLETION DATA:
- (1) diameter (inches) 4
 - (2) total depth (feet) 152
 - (3) static water level (feet) 30 below top of ground.
 - (4) casing plastic, 144,
(material) (depth)
4 if telescope see back.
(size)
 - (5) screen 8, 144
(length) (depth to top)
4, PVC
(size) (material)
 - (6) pump 1, 8
(HP) (yield gpm)
elec
(type power)
 - (7) electric log no
(yes or no)
(organization running log)
 - (8) how well bottom plugged sealed

CODED


DEPT. OF WATER CONTROL
OCT 16 1975

DRILLERS REMARKS:

MISS. RD. OF WATER CONTROL

If well telescopes please sketch and show depths.

GROUND LEVEL

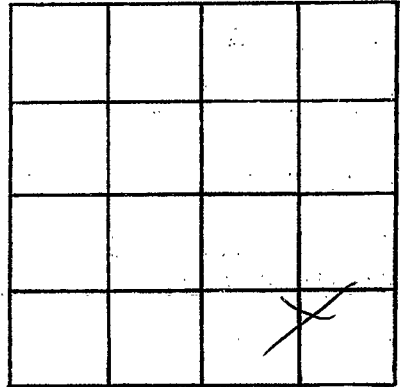

SECTION 29

Please indicate well location X.

ADDITIONAL INFORMATION

If more than one screen, show locations of each on sketch.