

Walthall

D63

2/20/78

MISSISSIPPI BOARD OF WATER COMMISSIONERS
416 North State Street
Jackson, Mississippi 39201

CODED

WATER WELL DRILLERS LOG

2/20/78
date well completed

Greer Drilling Service
firm name

Walthall Co.
county well located

LANDOWNER: Toxaco Inc.

#2 H.J. Packwood

(mailing address)

WELL LOCATION:

sec. 22 T. 3 (N) R. 11 (E)
1960'S & 1810'S of NE cor. W
miles of Kokomo
(distance) (direction) (nearest town)

WELL PURPOSE:

(home, irrigation, municipal, industrial)

WELL COMPLETION DATA:

- (1) diameter (inches) 4"
- (2) total depth (feet) 357
- (3) static water level (feet) 80 below above top of ground.
- (4) casing Steel, 357'
(material), (depth)
4"
(size) if telescope see back.
- (5) screen 42', 317'
(length), (depth to top)
3", Perforated Pipe
(size), (material)
- (6) pump —, 65
(HP), (yield gpm)
AC
(type power)
- (7) electric log NO
(yes or no)
NA
(organization running log)
- (8) how well bottom plugged Orange
peel

description of formations encountered

from

to

Sand & Chalk

0

105

Sand & Gravel

105

357

CODED


DRILLERS REMARKS:

RECEIVED
MAR 10 1978

MISS. BD. OF WATER COMMISSIONERS

If well telescopes please
sketch and show depths.

GROUND LEVEL

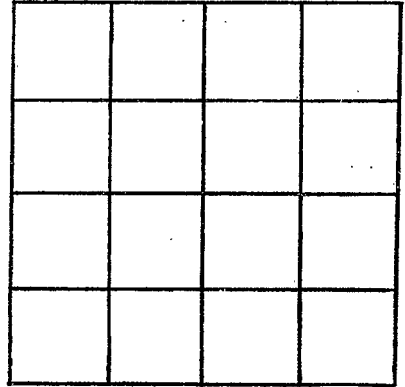

SECTION _____

Please indicate well location X.

ADDITIONAL INFORMATION

If more than one screen,
show locations of each on sketch.